


Give All Information Completely
Make Required Affidavit
Mail or Deliver Report to:
Conservation Division
State Corporation Commission
212 No. Market
Wichita, Kansas

WELL PLUGGING RECORD

Ness County, Sec. 32 Twp. 18S Rge. (E) 24 (W)

Location as "NE/CNW/SW" or footage from lines NE SE
Lease Owner Mull Drilling Company, Inc.
Lease Name MINER Well No. 1
Office Address 1625 Wichita Plaza Bldg. - Wichita, Kansas
Character of Well (completed as Oil, Gas or Dry Hole) Dry Hole
Date well completed 7-29 19 67
Application for plugging filed 7-29 19 67
Application for plugging approved 7-29 19 67
Plugging commenced 7-29 19 67
Plugging completed 11:50 A.M. 7-29 19 67
Reason for abandonment of well or producing formation No oil or gas found
in commercial quantities.
If a producing well is abandoned, date of last production -- 19 --
Was permission obtained from the Conservation Division or its agents before plugging was commenced? Yes

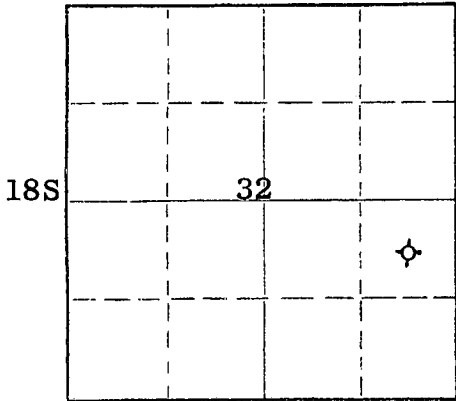

Locate well correctly on above Section Plat

Name of Conservation Agent who supervised plugging of this well Leo Massey, Hays, Kansas
Producing formation None Depth to top -- Bottom -- Total Depth of Well 4430 Feet
Show depth and thickness of all water, oil and gas formations.

OIL, GAS OR WATER RECORDS

CASING RECORD

FORMATION	CONTENT	FROM	TO	SIZE	PUT IN	PULLED OUT
				8-5/8"	425.16'	-0-

Describe in detail the manner in which the well was plugged, indicating where the mud fluid was placed and the method or methods used in introducing it into the hole. If cement or other plugs were used, state the character of same and depth placed, from feet to feet for each plug set.

Pushed plug to 680'. Spotted 90 sacks cement (50-50 pozmix, 6% gel). Mudded back to 40', set solid bridge and capped with 10 sacks cement, 2 sacks in rat hole.

RECEIVED
STATE CORPORATION COMMISSION

AUG 3 1967

CONSERVATION DIVISION
WICHITA, KANSAS

(If additional description is necessary, use BACK of this sheet)
Name of Plugging Contractor Rains & Williamson Oil Co., Inc.
Address 1425 Wichita Plaza Bldg. - Wichita, Kansas

STATE OF KANSAS, COUNTY OF SEDGWICK, ss.

Robert D. Palmateer (employee of owner) or (owner or operator) of the above-described well, being first duly sworn on oath, says: That I have knowledge of the facts, statements, and matters herein contained and the log of the above-described well as filed and that the same are true and correct. So help me God.

(Signature) Robert D. Palmateer
1425 Wichita Plaza - Wichita, Kansas
(Address)

SUBSCRIBED AND SWORN to before me this 2 day of August, 19 67

My commission expires June 30, 1971

Sherry Gish Notary Public

ROTARY DRILLING LOG

Operator: Mull Drilling Company,
Inc.
MINER #1
NE SE Sec. 32-18S-24W
Ness County, Kansas

Contractor: Rains & Williamson
Oil Co., Inc.
Commenced: 7-19-67
Completed: 7-29-67

Remarks: Set 8-5/8" surface
casing at 425.16' w/
225 sacks GL-3.

Formations

Shale	195'
Shale and Shells	480'
Shale	1009'
Blaine Anhydrite	1022'
Shale	1090'
Sand	1345'
Shale	1400'
Shale and Shells	1627'
Anhydrite	1672'
Shale and Shells	1805'
Shale	2305'
Lime and Shale	2825'
Shale and Lime	3240'
Shale	3400'
Shale and Lime	3700'
Lime	4290'
Lime and Shale	4338'
Lime	4425'
Lime and Sand	4430'
Rotary Total Depth (D & A)	4430'

RECEIVED
STATE CORPORATION COMMISSION

AUG 3 1967

CONSERVATION DIVISION
Wichita, Kansas

We certify the above log is true and correct to the best of our knowledge and belief.

RAINS & WILLIAMSON OIL CO., INC.

Robert D. Palmateer
Robert D. Palmateer



Subscribed and sworn to before me, a Notary Public within and for the State of Kansas, County of Sedgwick, this 2nd day of August, 1967.

Sherry Gish
Sherry Gish / Notary Public

My Commission Expires:
June 30, 1971