


STATE OF KANSAS
STATE CORPORATION COMMISSION

15-135-21615-00-00

WELL PLUGGING RECORD

Give All Information Completely
Make Required Affidavit
Mail or Deliver Report to
Conservation Division
State Corporation Comm.
245 North Water
Wichita, KS 67202

Ness County, Sec. 19 Twp 17S Rge. 24W E/W
Location as "NE/CNW 1/4 SW 1/4" or footage from lines
150' E of NE NW
Lease Owner Martin Exploration
Lease Name Mildred Schaben Well No. #1
Office Address 527 Union Center, Wichita, Kansas 67202
Character of Well (Completed as Oil, Gas or Dry Hole)
dry hole

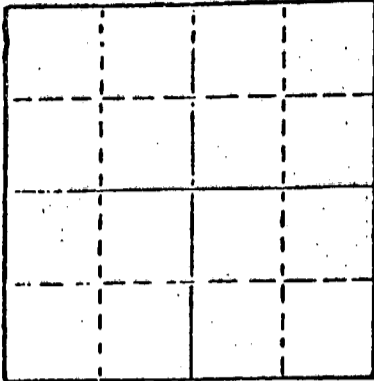

Locate well correctly on above
Section Plot

Date Well completed May 7, 1979 19
Application for plugging filed May 7, 1979 19
Application for plugging approved May 7, 1979 19
Plugging commenced May 7, 1979 19
Plugging completed May 7, 1979 19
Reason for abandonment of well or producing formation
dry hole
If a producing well is abandoned, date of last production
19

Was permission obtained from the Conservation Division or
its agents before plugging was commenced? yes

Name of Conservation Agent who supervised plugging of this well Leo Massey
Producing formation _____ Depth to top _____ Bottom _____ Total Depth of Well 4388'
Show depth and thickness of all water, oil and gas formations.

OIL, GAS OR WATER RECORDS

CASING RECORD

FORMATION	CONTENT	FROM	TO	SIZE	PUT IN	PULLED OUT

Describe in detail the manner in which the well was plugged, indicating where the mud fluid
was placed and the method or methods used in introducing it into the hold. If cement or other
plugs were used, state the character of same and depth placed, from _____ feet to
_____ feet for each plug set. Hole plugged with 50-50 pozmix, 6% gel, as follows:
70 sacks @ 720'; 20 sacks @ 240'; hulls and 10 sacks @ 40'. Plugging completed
at 12:15 p.m., May 7, 1979.

RECEIVED
STATE CORPORATION COMMISSION

(If additional description is necessary, use BACK of this sheet)
Name of Plugging Contractor Strata Drilling Company
OCT 24 1979
10-04-1979
CONSERVATION DIVISION
Wichita, Kansas


STATE OF KANSAS COUNTY OF BARTON, ss.
Charles W. Steincamp (employee of owner) or (owner or operator)
of the above-described well, being first duly sworn on oath, says: That I have knowledge of
the facts, statements, and matters herein contained and the log of the above-described well
as filed and that the same are true and correct. So help me God.

(Signature) Charles W. Steincamp
P. O. Box 355, Great Bend, Kansas 67530
(Address)

SUBSCRIBED AND SWORN TO before me this 14th day of May, 19 79

Loneita Barry
Loneita Barry Notary Public.

My commission expires 3-28-80

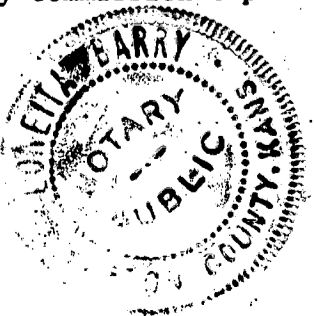

D R I L L E R S L O G

15-135-21615-00-00

#1 Mildred Schaben

CASING RECORD:
7 jts. new 20#
8-5/8" surface
casing

COMPANY: Martin Exploration
CONTRACTOR: Strata Drilling Company
COMMENCED: April 28, 1979
COMPLETED: May 7, 1979

DESCRIPTION: 150' E/NE NW
 Section 19-17S-24W
 Ness County, Kansas

ELEVATION: 2401' GL

TOTAL ROTARY
DEPTH: 4388'

D & A

<u>FORMATION</u>	<u>FROM</u>	<u>TO</u>	<u>REMARKS</u>
Surface soil and shale	0	300	Ran 283' new 20# 8-5/8" surface casing; set and cemented at 288' with 190 sacks common cement, 2% gel, 3% C.C. Cement circulated. Plug down at 7:00 p.m., April 28, 1979.
Shale, sand, shale	300	1661	
Anhydrite	1661	1691	
Shale	1691	2505	
Lime and shale	2505	3710	
Lime	3710	3890	
Lime and Shale	3890	4355	Ran six drill stem tests.
Mississippi	4355	4388	Ran one electric log.
			Hole plugged with 50-50 pozmix, 6% gel, as follows: 70 sacks @ 720', 20 sacks @ 240', hulls and 10 sacks @ 40'. Plugging completed at 12:15 p.m., May 7, 1979.

STATE OF KANSAS)
)ss
COUNTY OF BARTON)

I certify that this is a true and correct copy of the above log to the best of my knowledge.

STRATA DRILLING COMPANY

Charles W. Steincamp
Charles W. Steincamp

Sworn to and subscribed before me this 15th day of May, 1979.

My appointment expires 3-28-80.

Loneita Barry
Loneita Barry, Notary Public



RECEIVED
STATE CORPORATION COMMISSION

OCT - 4 1979
10-04-1979
CONSERVATION DIVISION
Wichita, Kansas