


STATE OF KANSAS
STATE CORPORATION COMMISSION

15-135-20777-00-00 Form CP-4

Give All Information Completely
Make Required Affidavit
Mail or Deliver Report to:
Conservation Division
State Corporation Commission
212 No. Market
Wichita, Kansas

WELL PLUGGING RECORD

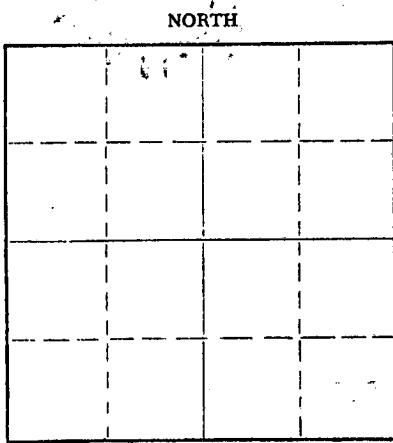

Locate well correctly on above
Section Plat

Ness County, Sec. 15 Twp. 17S Rge. 24 (W)
Location as "NE/CNW%SW%" or footage from lines 150' E of C SE NW
Lease Owner Stewart Brothers
Lease Name Noll Well No. 1
Office Address 416 Union Center Bldg., Wichita, Ks. 67202
Character of Well (completed as Oil, Gas or Dry Hole) dry hole
Date well completed August 17, 19 73
Application for plugging filed August 27, 19 73
Application for plugging approved 19
Plugging commenced August 17, 19 73
Plugging completed August 17, 19 73
Reason for abandonment of well or producing formation dry hole

If a producing well is abandoned, date of last production 19
Was permission obtained from the Conservation Division or its agents before plugging was commenced? yes

Name of Conservation Agent who supervised plugging of this well Leo F. Massey
Producing formation Depth to top Bottom Total Depth of Well 4528 Feet
Show depth and thickness of all water, oil and gas formations.

OIL, GAS OR WATER RECORDS

CASING RECORD

FORMATION	CONTENT	FROM	TO	SIZE	PUT IN	PULLED OUT
Surface Pipe		-0-	240'	8-5/8"	8/2/73	None

Describe in detail the manner in which the well was plugged, indicating where the mud fluid was placed and the method or methods used in introducing it into the hole. If cement or other plugs were used, state the character of same and depth placed, from feet to feet for each plug set.

Set bottom plug @ 720' w/70 sacks cement;
Set middle plug @ 240' w/20 sacks cement;
Set top plug @ 40' w/10 sacks cement.

RECEIVED
STATE CORPORATION COMMISSION

AUG 29 1973

CONSERVATION DIVISION
Wichita, Kansas

08-29-1973

(If additional description is necessary, use BACK of this sheet)
Name of Plugging Contractor E. K. Edmiston Drilling Co., Inc.
Address 405 First National Bank Bldg., Wichita, Ks. 67202


STATE OF KANSAS, COUNTY OF SEDGWICK, ss.
Norman R. Stewart (employer, owner or (owner or operator) of the above-described well, being first duly sworn on oath, says: That I have knowledge of the facts, statements, and matters herein contained and the log of the above-described well as filed and that the same are true and correct. So help me God.

(Signature) Norman R. Stewart
416 Union Center Bldg., Wichita, Ks.

(Address) 73.

Subscribed and sworn to before me this 28th day of August, 19 73.

My commission expires July 27, 1975.
Wilma Riller, Notary Public.

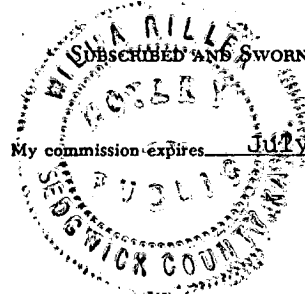

15-135-20777-00-00

RECEIVED
STATE CORPORATION COMMISSION

AUG 29 1973
08-29-1973
CONSERVATION DIVISION
Wichita, Kansas

DRILLER'S LOG

COMPANY: Stewart Brothers
416 Union Center Building
Wichita, Kansas 67202

ROTARY DRILLING COMMENCED: August 2, 1973

ROTARY DRILLING COMPLETED: August 17, 1973

WELL NAME: #1 NOLL

LOCATION: 150' East of C SE NW Sec. 15-17S-24W
Ness County, Kansas

CONTRACTOR: E. K. Edmiston Drilling Co., Inc.
405 First National Bank Bldg.
Wichita, Kansas 67202


CASING RECORD: Set 240' of 8-5/8" surface pipe
with 270 sacks cement.

L O G

Measurements from top of Kelly Bushing (Elevation 2499 K.B.)

Shale	0 - 1151
Shells	1161
Red Bed and Shale	1779
Anhydrite	1810
Red Bed and Shale	1885
Shale and Lime	4402
Lime	4465
Sand	4480
Lime	4528 R.T.D.

The undersigned, E. K. Edmiston, President of E. K. Edmiston Drilling Company, Inc., hereby certifies on behalf of said company, that the above log is a true and correct log of the formations encountered in drilling the above well, as reflected by the daily drilling reports.

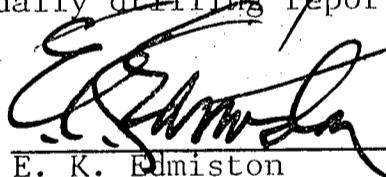

E. K. Edmiston

STATE OF KANSAS)
) SS:
COUNTY OF SEDGWICK)

BE IT REMEMBERED that on this 23rd day of August, 1973, before me, the undersigned, a Notary Public, within and for the County and State aforesaid, came E. K. EDMISTON, known to me to be the same person who executed the foregoing instrument on behalf of E. K. Edmiston Drilling Company, Inc., and he duly acknowledged the execution of the same for himself and for said company.

IN WITNESS WHEREOF, I have hereunto set my hand and official seal on the day and year last above written.

My Commission Expires:
November 9, 1973

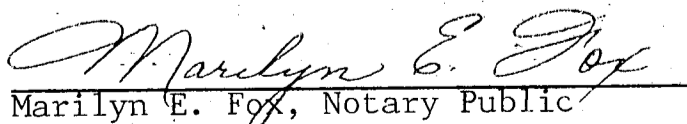
Marilyn E. Fox, Notary Public

