


15-135-00184-00-00
WELL PLUGGING RECORD

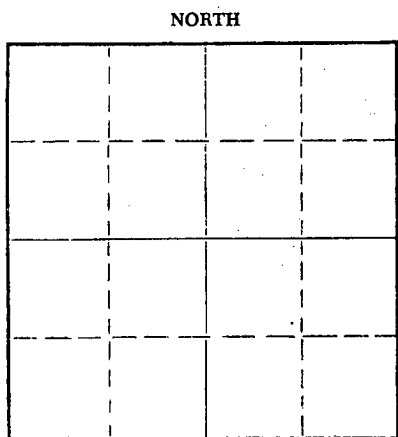

Locate well correctly on above
Section Plat

Ness County. Sec. 14 Twp. 18 Rge. 25 (E) W (W)
Location as "NE/CNW%SW%" or footage from lines C NW SW
Lease Owner Harms-Burt Drilling Company
Lease Name Anspaugh Well No. 1
Office Address P. O. Box 184, Great Bend, Kansas
Character of Well (completed as Oil, Gas or Dry Hole) Dry Hole
Date well completed May 20, 19 60
Application for plugging filed May 20 19 60
Application for plugging approved May 20 (verbally) 19 60
Plugging commenced May 20 19 60
Plugging completed May 20 19 60
Reason for abandonment of well or producing formation Dry Hole

If a producing well is abandoned, date of last production 19
Was permission obtained from the Conservation Division or its agents before plugging was commenced? Yes

Name of Conservation Agent who supervised plugging of this well
Producing formation Depth to top Bottom Total Depth of Well 4462 Feet
Show depth and thickness of all water, oil and gas formations.

OIL, GAS OR WATER RECORDS

CASING RECORD

FORMATION	CONTENT	FROM	TO	SIZE	PUT IN	PULLED OUT
Surface		0	200'	8 5/8"	200'	none

Describe in detail the manner in which the well was plugged, indicating where the mud fluid was placed and the method or methods used in introducing it into the hole. If cement or other plugs were used, state the character of same and depth placed, from feet to feet for each plug set.

Filled hole with heavy mud from total depth to 600' with plug and 20 sacks of cement at this point. Filled with heavy mud to a depth of 200 feet with plug and 20 sacks of cement at this point. Mud to 40 feet with a plug and 10 sacks of cement at this point.

RECEIVED
STATE CORPORATION COMMISSION

JUN 3 1960

CONSERVATION DIVISION
Wichita, Kansas

06-03-1960

(If additional description is necessary, use BACK of this sheet)

Name of Plugging Contractor Harms-Burt Drilling Company
Address P. O. Box 184, Great Bend, Kansas

STATE OF Kansas, COUNTY OF Barton, ss.
Allan Harms (employee of owner) or (owner or operator) of the above-described

well, being first duly sworn on oath, says: That I have knowledge of the facts, statements, and matters herein contained and the log of the above-described well as filed and that the same are true and correct. So help me God:

(Signature) Allan Harms

P. O. Box 184, Great Bend, Kansas
(Address)

SUBSCRIBED AND SWORN to before me this 28 day of May, 19 60

Mary E. Van Pelt

Notary Public.

My commission expires January 20, 1962



15-135-00184-00-00

D R I L L E R S L O G

Company: Harms-Burt Drilling Company
Farm: Anspaugh #1
Commenced: May 5, 1960

C NW SW - Section 14-18-25W
Ness County, Kansas
Completed: May 20, 1960

Elevation: 2449 KB

0 - 410	shale
410 - 550	sand & shale
550 - 650	Dakota sand
650 - 700	shale
700 - 940	shale & sand streaks
940 - 1110	Red bed & shale
1110 - 1135	anhydrite
1135 - 1450	red bed, shale & sand
1450 - 1500	red bed-shale
1500 - 2125	shale & lime
2125 - 2630	lime & shale
2630 - 3600	lime
3600 - 3795	lime & chalk
3795 - 4435	lime
4435 - 4462	Mississippian
4462	Total depth

Set 200 feet of 8 5/8" surface pipe. Cemented with 140 sacks of common cement with 2% calcium chloride.

Tops: Anhydrite	-	1110'
Heebner	-	3795'
Lansing KC	-	3839'
Ft. Scott	-	4340'
Conglomerate	-	4426'
Mississippi		
Lime	-	4437'

Drill Stem Tests: #1 - 4438-4451

Test Failed

#1 - 4444-4451

Open 21 minutes. Shut in 20 min.

Recovered 5' mud. IBHP-25# FBHP-25#

#2 - Straddle test -

Open 1 hour. Shut in 20 min. Recovered 320' muddy water and 120' water.

IBHP-1325# FBHP-1178# IFP-75# FFP-270#

Ran electric log.

Dry, plugged and abandoned.

RECEIVED
STATE CORPORATION COMMISSION

06-03-1960
JUN 3 1960

CONSERVATION DIVISION
Wichita, Kansas

A F F I D A V I T

STATE OF KANSAS)
)SS.
COUNTY OF BARTON)

I, Allan Harms of the Harms-Burt Drilling Company being first duly sworn on oath state: I have knowledge of the facts, statements and matters herein contained and the same are true and correct.

Subscribed and sworn to before me this 28 day of May, 1960.

My commission expires January 20, 1962.

Mary E. Van Pelt
Notary Public.