


STATE OF KANSAS
STATE CORPORATION COMMISSION

Form CP-4

Give All Information Completely
Make Required Affidavit
Mail or Deliver Report to:
Conservation Division
State Corporation Commission
212 No. Market
Wichita, Kansas

WELL PLUGGING RECORD

NORTH

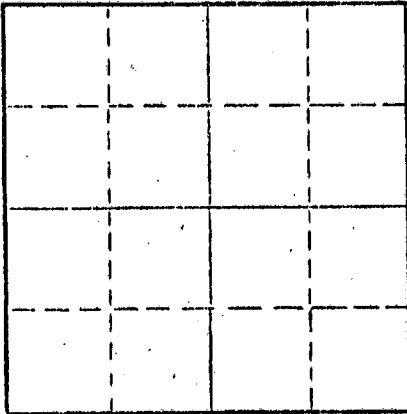Locate well correctly on above
Section Plat

Ness County, Sec. 25 Twp. 19S Rge. (E) 23 (W)
Location as "NE/CNW/SW" or footage from lines C NE SW
Lease Owner Pickrell Drilling Company
Lease Name Uehling "A" Well No. 1
Office Address 705 4th National Bank Bldg., Wichita 2, Kansas
Character of Well (completed as Oil, Gas or Dry Hole) Dry Hole
Date well completed April 7, 1968
Application for plugging filed April 7, 1968
Application for plugging approved April 7, 1968
Plugging commenced April 7, 1968
Plugging completed April 7, 1968
Reason for abandonment of well or producing formation Dry Hole

If a producing well is abandoned, date of last production 19
Was permission obtained from the Conservation Division or its agents before plugging was commenced? Yes

Name of Conservation Agent who supervised plugging of this well Leo F. Massey, Hays, Kansas
Producing formation Depth to top Bottom Total Depth of Well 4434 Feet
Show depth and thickness of all water, oil and gas formations.

OIL, GAS OR WATER RECORDS

CASING RECORD

FORMATION	CONTENT	FROM	TO	SIZE	PUT IN	PULLED OUT
				8 5/8"	273'	None

Describe in detail the manner in which the well was plugged, indicating where the mud fluid was placed and the method or methods used in introducing it into the hole. If cement or other plugs were used, state the character of same and depth placed, from feet to feet for each plug set.

Heavy mud to 525'. Set plug. Cemented with
80 sacks cement. Heavy mud to 300'. Set plug.
Cemented with 15 sacks. Set plug. Heavy mud
to 40'. Set plug. Cemented with 10 sacks cement
to bottom of cellar. Plugged rat hole with 2
sacks cement.

RECEIVED
STATE CORPORATION COMMISSION
APR 22 1968
CONSERVATION DIVISION
Wichita, Kansas

(If additional description is necessary, use BACK of this sheet)

Name of Plugging Contractor Pickrell Drilling Company
Address 705 4th National Bank Building, Wichita 2, Kansas

STATE OF KANSAS, COUNTY OF SEDGWICK, ss.
C. W. SEBITS (employee of owner) or (owner or operator) of the above-described

I, the first duly sworn on oath, says: That I have knowledge of the facts, statements and matters herein contained and the log of the
described well as filed and that the same are true and correct. So help me God.

(Signature)

C. W. Sebits
705 4th National Bank Bldg., Wichita 2, Ks.
(Address)


Sworn to before me this 18th day of April, 1968.

L. M. Whiting

Notary Public.

May 10, 1970

My commission expires

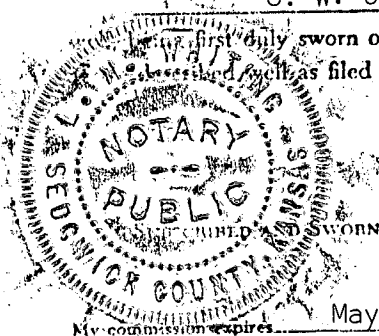

15-135-20136-0000
ROTARY DRILLING LOG

COMPANY: PICKRELL DRILLING COMPANY
705 4th National Bank Bldg.
Wichita, Kansas

Rotary Drilling Commenced 3/26/68

Rotary Drilling Completed 4/7/68

LOCATION: Uehling "A" No. 1, C NE SW Section 25-19S-23W, Ness County, Kansas.

CONTRACTOR: **PICKRELL DRILLING COMPANY**
Wichita, Kansas

CASING RECORD: (13 jts) 8 5/8" surface casing set at 273', cemented with 165 sacks cement. Circulated. Completed 6:15 P.M. March 26, 1968. No oil string run. D & A.

LOG

(Figures indicate bottom of formation — measurements from top of rotary bushing.)

40	Clay
75	Post Rock
750	Shale & Shells
761	Blaine
950	Shale & Shells
1200	Sand
1548	Shale & Shells
1587	Anhydrite
1900	Shale & Shells
2620	Lime & Shale
2755	Lime
3870	Lime & Shale
4335	Lime
4377	Lime & Shale
4404	Shale
4434	Lime & Chert, RTD

C. F. S.

4315
4331
4357
4377
4395
4405
4413
4424
4434

RECEIVED
STATE CORPORATION COMMISSION
APR 22 1968
CONSERVATION DIVISION
Wichita, Kansas

Slope Tests

2000
2500
3000
3500
4000

S. L. M.

Board 4091.88
Strap 4090.51

Difference 1.37

The undersigned, C. W. SEBITS, Attorney-in-Fact for PICKRELL DRILLING COMPANY, hereby certifies in behalf of said Company, that the above is a true and correct log of the formation encountered in drilling the above well as reflected by the Daily Drilling Reports.

PICKRELL DRILLING COMPANY

By C. W. SEBITS, Attorney-in-Fact

STATE OF KANSAS }
COUNTY OF SEDGWICK } ss.:

On this 18th day of April, 19 68, before me the undersigned, a Notary Public, in and for the County and State aforesaid, personally appeared C. W. SEBITS, to me known to be the identical person who subscribed the name of PICKRELL DRILLING COMPANY to the foregoing instrument as its Attorney-in-Fact and acknowledged to me that he executed the same as his free and voluntary act and deed, and as the free and voluntary act and deed of such company, for the uses and purposes therein set forth.

Given under my hand and seal of office the day and year last above written.

My commission expires: May 10, 1970

L. M. Whiting
L. M. Whiting, Notary Public