


STATE OF KANSAS
STATE CORPORATION COMMISSION
200 Colorado Derby Bldg.
Wichita, Kansas 67202

Form CP-4
Rev. 12-15-80

WELL PLUGGING RECORD

Give All Information Completely
Make Required Affidavit

COUNTY NESS SEC. 23 TWP. 19S RGE. 23W E/W
Location as in quarters or footage from lines:
C SW SW

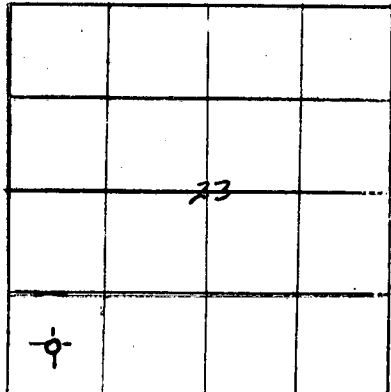

Locate Well
correctly on above
Section Platt.

Lease Owner Bird Energy, Inc.
Lease Name Maranville Well No. 1
Office Address P. O. Box 1612, Dodge City, KS 67801
Character of Well (Completed as Oil, Gas or Dry Hole): Dry Hole
Date Well Completed March 10, 1983
Application for plugging filed March 10, 1983
Plugging commenced March 10, 1983
Plugging completed March 10, 1983
Reason for abandonment of well or producing formation _____

Was permission obtained from the Conservation Division or it's
Agent's before plugging was commenced? yes

Name of Conservation Agent who supervised plugging of this well Tarbutton

Producing formation _____ Depth to top _____ bottom _____ T.D. 4424

Show depth and thickness of all water, oil and gas formations.

OIL, GAS OR WATER RECORDS Casing Record

Formation	Content	From	To	Size	Put in	Pulled Out
Surface	shale	0	595	8-5/8	594	none
cemented with 425 sx 60/40 pos, 2%Gel, 3%cc, plug down at 6:45 p.m. 3-2-83 By Sun; cement did circ.						

Describe in detail the manner in which the well was plugged, indicating where the mud fluid was placed and the method or methods used in introducing it into the hold. If cement or other plugs were used, state the character of same and depth placed, from _____ feet to _____ feet for each plug set.


Plugged as follows:

50 sx @ 1527'; 40 sx @ 657'; 15 sx in rat hole; 10 sx @ 40'
with solid bridge plug
used 50/50 posmix, 4%gel, 3% cc;
Job completed at 7:30 p.m. 3-10-83 by Halliburton

(If additional description is necessary, use BACK of this sheet)

Name of Plugging Contractor J. W. Drilling Co., Inc.

STATE OF KANSAS COUNTY OF SEDGWICK, ss. _____
Jon T. Williams, Jr. (employee of owner) or (owner or operator) of the
above-described well, being first duly sworn on oath, says: That I have knowledge of the
facts, statements, and matters herein contained and the log of the above-described well as
filed and that the same are true and correct. So help me God.

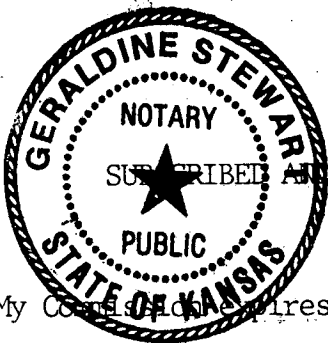

MAR 24 1983

CONSERVATION DIVISION
Wichita, Kansas

SWORN TO before me this _____

(Signature) [Signature]
200 E. First, Suite 500, Wichita, KS
(Address)

10th day of March, 1983

Geraldine Stewart
Notary Public.

My Comm. Expires: January 14, 1985 Geraldine Stewart