

15-135-28263-0000

STATE OF KANSAS  
STATE CORPORATION COMMISSION

Form CP-4

WELL PLUGGING RECORD

Give All Information Completely  
Make Required Affidavit  
Mail or Deliver Report to:  
Conservation Division  
State Corporation Commission  
212 No. Market  
Wichita, Kansas

Ness County, Sec. 22 Twp. 19S Rge. (E) 23 (W)

Location as "NE/CNW/SW" or footage from lines C SW SW

Lease Owner: Pickrell Drilling Company

Lease Name: Goodman "A" Well No. 1

Office Address: 705 Fourth National Bank Bldg., Wichita, Kansas

Character of Well (completed as Oil, Gas or Dry Hole) Dry Hole

Date well completed July 5 19 69

Application for plugging filed July 5 19 69

Application for plugging approved July 5 19 69


Plugging commenced July 5 19 69

Plugging completed July 5 19 69

Reason for abandonment of well or producing formation Dry Hole

If a producing well is abandoned, date of last production 19

Was permission obtained from the Conservation Division or its agents before plugging was commenced? Yes

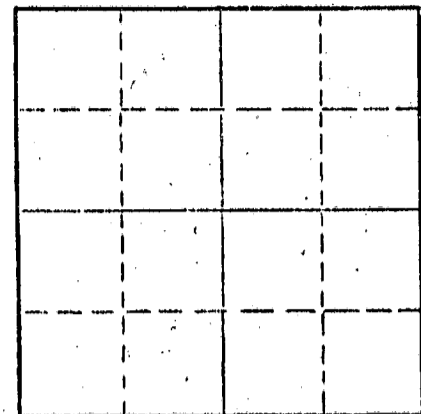

Locate well correctly on above Section Plat

Name of Conservation Agent who supervised plugging of this well Leo F. Massey

Producing formation Depth to top Bottom Total Depth of Well Feet

Show depth and thickness of all water, oil and gas formations.

OIL, GAS OR WATER RECORDS

CASING RECORD

FORMATION	CONTENT	FROM	TO	SIZE	PUT IN	PULLED OUT
				8-5/8"	504'	None

Describe in detail the manner in which the well was plugged, indicating where the mud fluid was placed and the method or methods used in introducing it into the hole. If cement or other plugs were used, state the character of same and depth placed, from feet to feet for each plug set.

Bottom Plug 500', 30 sacks cement

Top Plug @ 40', 10 Sacks cement

RECEIVED  
STATE CORPORATION COMMISSION  
JUL 11 1969  
CONSERVATION DIVISION  
Wichita, Kansas

(If additional description is necessary, use BACK of this sheet)

Name of Plugging Contractor: Pickrell Drilling Company


Address: 705 Fourth National Bank Bldg., Wichita, Kansas 67202

STATE OF Kansas COUNTY OF Sedgwick, ss. C. W. Sebitts (employee of owner) or (owner or operator) of the above-described

sworn on oath, says: That I have knowledge of the facts, statements and matters herein contained and the log of the described well as filed and that the same are true and correct. So help me God.

(Signature) C. W. Sebitts  
705 Fourth National Bank Bldg., Wichita, Ks.  
(Address)

sworn to before me this 9th day of July, 19 69

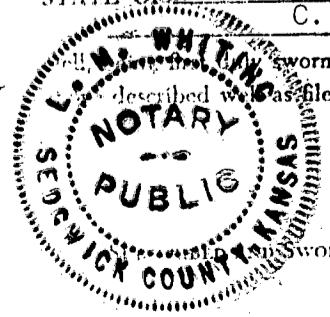

L. M. Whiting  
Notary Public.

My commission expires May 10, 1970

15.135-20263-0000  
ROTARY DRILLING LOG

COMPANY: Pickrell Drilling Company  
705 Fourth National Bank Bldg.  
Wichita, Kansas 67202

Rotary Drilling Commenced 6/23/69

Rotary Drilling Completed 7/5/69

LOCATION: Goodman "A" No. 1, C SW SW SEC. 22-19S-23W  
Ness County, Kansas

CONTRACTOR: **PICKRELL DRILLING COMPANY**  
Wichita, Kansas

CASING RECORD: Ran 13 jts. 28# 8-5/8" surface casing set @ 503' KB. Cemented with 225 sacks. Completed @ 11:45 June 23, 1969. Circulated. No oil string run. D & A Plugged July 5, 1969

LOG

(Figures indicate bottom of formation — measurements from top of rotary bushing.)

50	Clay & Post Rock		<u>C.F.S.</u>
130	Post Rock		4272
504	Shale & Shells		4295
875	Shale, clay & Red Beds		4315
915	Blaine		4345
970	Shale & Sand stringers		4365
1180	Sand		4375
1360	Shale & Sand		
1503	Shale		
1556	Anhydrite		
2470	Shale & Lime		<u>S.L.M.</u>
2775	Lime & Shale		
3585	Shale & Lime	Board	3587.48
3655	Lime & Shale	Strap	<u>3586.30</u>
3780	Shale & Lime		1.18 Difference
4095	Lime & Shale		
4272	Ft. Scott		
4344	Sandy Lime & Shale		<u>Slope Tests</u>
4375	Mississippian & RTD		2000
			2500
			3000
			3500
			4000

RECEIVED  
STATE CORPORATION COMMISSION  
JUL 1 1 1969  
CONSERVATION DIVISION  
Wichita, Kansas

The undersigned, C. W. Sebitts, Attorney-in-Fact for PICKRELL DRILLING COMPANY, hereby certifies in behalf of said Company, that the above is a true and correct log of the formation encountered in drilling the above well as reflected by the "Daily Drilling Reports."

PICKRELL DRILLING COMPANY

By C. W. Sebitts Attorney-in-Fact

STATE OF KANSAS  
COUNTY OF SEDGWICK } ss.:

On this 9th day of July, 1969, before me the undersigned, a Notary Public, in and for the County and State aforesaid, personally appeared C. W. Sebitts, to me known to be the identical person who subscribed the name of PICKRELL DRILLING COMPANY to the foregoing instrument as its Attorney-in-Fact and acknowledged to me that he executed the same as his free and voluntary act and deed, and as the free and voluntary act and deed of such company, for the uses and purposes therein set forth.

My commission expires: May 10, 1970

L. M. Whiting  
L. M. Whiting Notary Public

