

15-135-20439-0000

STATE OF KANSAS
STATE CORPORATION COMMISSION

Form CP-4

Give All Information Completely
Make Required Affidavit
Mail or Deliver Report to:
Conservation Division
State Corporation Commission
212 No. Market
Wichita, Kansas 67202

WELL PLUGGING RECORD

Ness County, Sec. 14 Twp. 19 Rge. 23 (E) W (W)

Location as "NE/CNW%SW%" or footage from lines C SW SE
Lease Owner Pickrell Drilling Co.

Lease Name Pfaff Well No. # 1

Office Address 705 Fourth National Bank Bldg.; Wichita, Ks. 67202

Character of Well (completed as Oil, Gas or Dry Hole) oil

Date well completed June 29 19 71

Application for plugging filed August 26 19 71

Application for plugging approved August 26 19 71


Plugging commenced August 26 19 71

Plugging completed August 30 19 71

Reason for abandonment of well or producing formation Dry Hole

If a producing well is abandoned, date of last production August 8 19 71

Was permission obtained from the Conservation Division or its agents before plugging was commenced? Yes

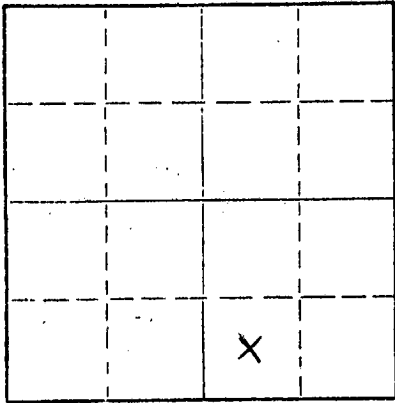

Locate well correctly on above Section Plat

Name of Conservation Agent who supervised plugging of this well Leo Massey

Producing formation Mississippi Depth to top 4317 Bottom ----- Total Depth of Well 4341 Feet

Show depth and thickness of all water, oil and gas formations.

OIL, GAS OR WATER RECORDS

CASING RECORD

FORMATION	CONTENT	FROM	TO	SIZE	PUT IN	PULLED OUT
				8-5/8"	272	None
				5-1/2"	4332	3210

Describe in detail the manner in which the well was plugged, indicating where the mud fluid was placed and the method or methods used in introducing it into the hole. If cement or other plugs were used, state the character of same and depth placed, from _____ feet to _____ feet for each plug set.

August 26, 1971 Plugged off bottom. Dumped sand to 4300'. Mixed and dumped 5 sx of cement.

August 30, 1971 Plugged off top. Globe Oil Well Cementing Co. mixed and pumped down 8-5/8" surface casing; 2 hulls, 20 gel, 1 hulls and 130 sx of cement + 6 % gel.

RECEIVED
STATE CORPORATION COMMISSION
SEP 20 1971
CONSERVATION DIVISION
Wichita, Kansas

(If additional description is necessary, use BACK of this sheet)

Name of Plugging Contractor RUSS CASING PULLING, INC.

Address P. O. Box 1082 Great Bend, Kansas 67530

STATE OF KANSAS, COUNTY OF SEDGWICK, ss.

I, Dale M. Robinson (employee of owner) or (owner or operator) of the above-described well, being first duly sworn on oath, says: That I have knowledge of the facts, statements, and matters herein contained and the log of the above-described well as filed and that the same are true and correct. So help me God.

(Signature)

Dale M. Robinson


Dale M. Robinson
705 Fourth National Bank Building, Wichita, Ks.
(Address)

Subscribed and sworn to before me this 17th day of September, 1971.

Ruth M. Sullivan

Notary Public.

My commission expires August 13, 1974

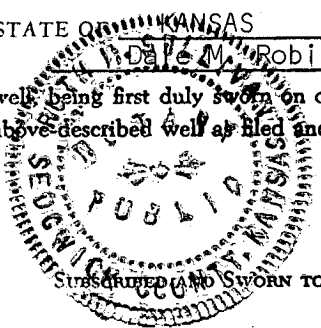

15-135-20439-0000

ROTARY DRILLING LOG

COMPANY: Pickrell Drilling Company
705 Fourth National Bank Building
Wichita, Kansas 67202

Rotary Drilling Commenced 5/5/71

Rotary Drilling Completed 5/15/71

LOCATION: Pfaff "L" No. 1, C SW SE Section 14-19S-23W,
Ness County, Kansas

CONTRACTOR: **PICKRELL DRILLING COMPANY**
Wichita, Kansas

CASING RECORD: Run 13 Jts. 8-5/8" surface casing set @ 272' KB. Cemented with 150 sacks. Completed 8:00 P.M. Circulated.

Ran 129 Jts. 5-1/2" casing set @ 4332'. Cemented w/100 sacks. Plug down at 7:20 P.M. May 15, 1971.

LOG

(Figures indicate bottom of formation — measurements from top of rotary bushing.)

90	Post Rock		<u>C.F.S.</u>	
271	Shale & Shells		3710	3980
935	Shale		3725	3985
1155	Sand		3755	4023
1489	Shale		3780	4044
1531	Anhydrite		3815	4247
1825	Shale & Lime		3835	4270
2205	Lime & Shale		3865	4290
2465	Shale & Lime Stringers		3900	4306
2765	Lime & Shale		3923	4315
3695	Shale & Lime		3955	4325
3740	Lime			4336
3875	Lime & Shale			4341
3923	Shale & Lime			
4044	Lime & Shale			
4115	Shale & Lime			
4308	Lime		<u>S.L.M.</u>	
4341	Miss., RTD		Strap 4264.81	
			Board 4263.01	

RECEIVED
STATE CORPORATION COMMISSION
AUG 26 1971
CONSERVATION DIVISION
Wichita, Kansas

1.80 Difference

Slope Tests

2000
2500
3000
3500
4000

The undersigned, C. W. Sebitts, Attorney-in-Fact for PICKRELL DRILLING COMPANY, hereby certifies in behalf of said Company, that the above is a true and correct log of the formation encountered in drilling the above well as reflected by the Daily Drilling Reports.

PICKRELL DRILLING COMPANY

By C. W. Sebitts Attorney-in-Fact

STATE OF KANSAS }
COUNTY OF SEDGWICK } ss.:

On this 18th day of May, 1971, before me the undersigned, a Notary Public, in and for the County and State aforesaid, personally appeared C. W. Sebitts, to me known to be the identical person who subscribed the name of PICKRELL DRILLING COMPANY to the foregoing instrument as its Attorney-in-Fact and acknowledged to me that he executed the same as his free and voluntary act and deed, and as the free and voluntary act and deed of such company, for the uses and purposes therein set forth.

Given under my hand and seal of office the day and year last above written.

My commission expires: Jan. 19, 1973

Esther Lamone
ESTHER Lamone Notary Public