


STATE OF KANSAS
STATE CORPORATION COMMISSION

15-135-20251-00 Form CP-4

Give All Information Completely
Make Required Affidavit
Mail or Deliver Report to:
Conservation Division
State Corporation Commission
212 No. Market
Wichita, Kansas

WELL PLUGGING RECORD

NORTH

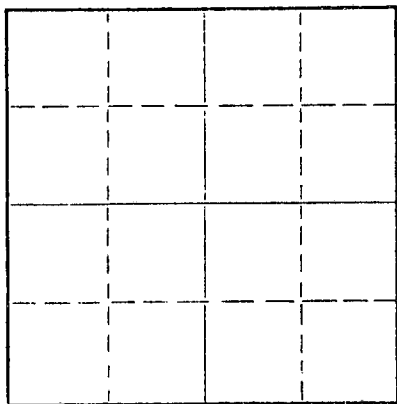

Locate well correctly on above
Section Plat

Ness County. Sec. 26 Twp. 19S Rge. (E) 25 (W)
Location as "NE/CNW/SW" or footage from lines C SE NW
Lease Owner Tilco, et al
Lease Name Fitzgerald Well No. A-1
Office Address 200 Sutton Place
Character of Well (completed as Oil, Gas or Dry Hole) Dry Hole
Date well completed 5-25 19 69
Application for plugging filed 5-25 19 69
Application for plugging approved 5-25 19 69
Plugging commenced 5-25 19 69
Plugging completed 5-25 19 69
Reason for abandonment of well or producing formation Dry Hole

If a producing well is abandoned, date of last production 19
Was permission obtained from the Conservation Division or its agents before plugging was commenced? Yes

Name of Conservation Agent who supervised plugging of this well Leo Massey
Producing formation Depth to top Bottom Total Depth of Well 4496 Feet
Show depth and thickness of all water, oil and gas formations.

OIL, GAS OR WATER RECORDS

CASING RECORD

FORMATION	CONTENT	FROM	TO	SIZE	PUT IN	PULLED OUT
				8 5/8"	412'	none

Describe in detail the manner in which the well was plugged, indicating where the mud fluid was placed and the method or methods used in introducing it into the hole. If cement or other plugs were used, state the character of same and depth placed, from feet to feet for each plug set.

Plugged with 70 sacks 50/50 Posmix @ 720'
Plugged with 20 sacks cement @ 390'
Bridged Plug @ 40' w/ 1/2 sx hulls 10 sx cement

RECEIVED
STATE CORPORATION COMMISSION
MAY 29 1969
CONSERVATION DIVISION
Wichita, Kansas

05-29-1969

(If additional description is necessary, use BACK of this sheet)


Name of Plugging Contractor Leben Drilling, Inc.
Address Box 486, Great Bend, Kansas 67530

STATE OF KANSAS, COUNTY OF BARTON, ss.
Leslie Kite (employee of owner) or (owner or operator) of the above-described well, being first duly sworn on oath, says: That I have knowledge of the facts, statements, and matters herein contained and the log of the above-described well as filed and that the same are true and correct. So help me God.

(Signature) Leslie Kite

(Address)

Subscribed and sworn to before me this 27th day of May, 1969

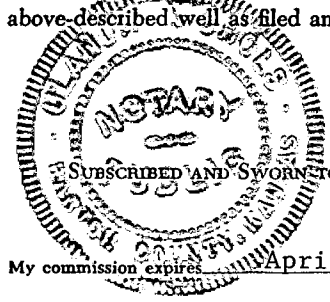

Ulanda Nichols
Notary Public.

My commission expires April 1, 1971

15-135-20251-00-00

DRILLER'S LOG

COMPANY	Tilco, et al
CONTRACTOR	LEBEN DRILLING, INC.
FARM	FITZGERALD A-1
LOCATION	C SE NW SECTION 26-19S-25W NESS COUNTY, KANSAS
COMMENCED	5-14-69
COMPLETED	5-25-69

0	40	Surface Clay, Sand
40	995	Shale, Sand
995	1689	Red Bed, Shale
1689	1729	Anhydrite
1729	2125	Shale, Shells
2125	2460	Shale, Lime
2460	3325	Lime, Shale
3325	3640	Shale, Lime
3640	3815	Lime, Shale
3815	4380	Lime
4380	4474	Lime Chert
4474	4496	Mississippi
	<u>4496</u>	<u>RTD - D. & A.</u>

RECEIVED
STATE CORPORATION COMMISSION
MAY 29 1969
CONSERVATION DIVISION
Wichita, Kansas
05-29-1969

8 5/8" 20# new surface casing set @ 412' cemented with 250 sacks Common cement, 2% cc

I, Leslie Kite, do hereby certify that the above and foregoing is a true and correct copy of the log of the Fitzgerald A-1 Well, located in C SE NW of Section 26, Township 19 South, Range 25 West, Ness County, Kansas, as reflected by the records of Leben Drilling, Inc.

Leslie Kite

Leslie Kite

STATE OF KANSAS)
) SS
COUNTY OF BARTON)

Subscribed and sworn to and before me, a Notary Public, in and for Barton County, Kansas, this 27th day of May, 1969.

Ulanda Nichols

Ulanda Nichols



My Commission Expires:
April 12, 1971