

15-135-20993-00-00


FORM CP-4

STATE OF KANSAS
STATE CORPORATION COMMISSION
CONSERVATION DIVISION
P. O. BOX 17027
WICHITA, KANSAS 67217

WELL PLUGGING RECORD

Ness County, Sec. 119 Twp. 19S Rge. (X) 25 (W)

Location as "NE/CNWxSWx" or footage from lines E/2 SE NW
Lease Owner Petroleum, Inc.
Lease Name SPRULL "B" Well No. 1
Office Address 801 Union Center, Wichita, Kansas 67202
Character of Well (completed as Oil, Gas or Dry Hole) Dry Hole
Date well completed March 31 1975
Application for plugging filed (verbal) March 31 1975
Application for plugging approved (verbal) March 31 1975
Plugging commenced March 31 1975
Plugging completed March 31 1975
Reason for abandonment of well or producing formation No commercial quantities of oil or gas encountered.

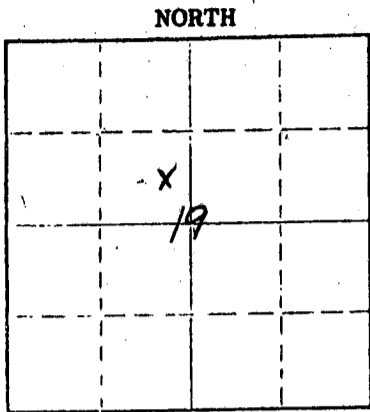

Locate well correctly on above Section Plot

If a producing well is abandoned, date of last production 19
Was permission obtained from the Conservation Division or its agents before plugging was commenced? Yes (verbally)

Name of Conservation Agent who supervised plugging of this well Leo Massey
Producing formation _____ Depth to top _____ Bottom _____ Total Depth of Well 4521 Feet
Show depth and thickness of all water, oil and gas formations.

OIL, GAS OR WATER RECORDS				CASING RECORD		
FORMATION	CONTENT	FROM	TO	SIZE	PUT IN	PULLED OUT
				8-5/8"	396'	None

Describe in detail the manner in which the well was plugged, indicating where the mud fluid was placed and the method or methods used in introducing it into the hole. If cement or other plugs were used, state the character of same and depth placed, from _____ feet to _____ feet for each plug set.

1st Plug Set @ 680' with 70 sacks cement
2nd Plug Set @ 240' with 20 sacks cement
3rd Plug Set @ 10' with 40 sacks cement


(If additional description is necessary, use BACK of this sheet)
Name of Plugging Contractor Abercrombie Drilling, Inc.
Address 801 Union Center, Wichita, Kansas 67202

STATE OF KANSAS COUNTY OF SEDGWICK, ss.
Jerry A. Langrehr, Exec. V. P. (employee of owner) or (owner or operator) of the above-described well, being first duly sworn on oath, says: That I have knowledge of the facts, statements, and matters herein contained and the log of the above-described well as filed and that the same are true and correct. So help me God.

(Signature) Jerry A. Langrehr
801 Union Center, Wichita, Kansas 67202
(Address)

SUBSCRIBED AND SWORN TO before me this 2nd day of April, 1975

April 8, 1978
Nancy E. Haner Notary Public.

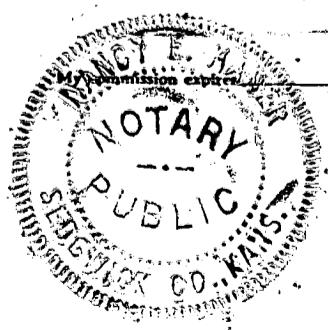

RECEIVED
STATE CORPORATION COMMISSION
APR 3 1975 04-03-1975
CONSERVATION DIVISION
Wichita, Kansas

CONTRACTOR'S WELL LOG

OPERATOR:
 CONTRACTOR:
 WELL NAME:
 LOCATION:
 GEOLOGIST:
 SPUD DATE:
 COMPLETION DATE:

RECEIVED
 STATE CORPORATION COMMISSION
 04-03-1975
 CONSERVATION DIVISION
 (Wichita, Kansas)

Petroleum, Incorporated
 Abercrombie Drilling, Inc.
 SPRUILL "B" #1
 E/2 SE NW Section 19-19S-25W
 Ness County, Kansas
 Gerald Becker
 March 11, 1975
 March 31, 1975

0	400	Shale
400	800	Shale & Sand
800	1365	Sand & Shale
1365	1550	Shale & Sand
1550	1580	Anhydrite
1580	2517	Shale
2517	3850	Shale & Lime
3850	4311	Lime & Shale
4311	4521	Lime
	4521	Rotary Total Depth
	4531	ELTD

Drilled 398' of 12 1/4" surface hole. Set 8-5/8" surface casing @ 396'.
 Cemented with 275 Sacks Common Cement, 2% gel, 3% Calcium Chloride.
 Cement circulated. Plug down @ 1:45 a.m., March 11, 1975.
 Plugged and Abandoned: 1st Plug Set @ 680' with 70 sx. cement, 2nd
 Plug @ 240' with 20 sx., 3rd Plug @ 10' with 40 sx. Plug down @ 7:00 p.m.,
 March 31, 1975.

<u>Sample Tops:</u>	<u>Elevation:</u>
Anhydrite 1550 (+987)	2537' K.B.
B/Anhydrite 1580 (+957)	2534' D.F.
	2529' G.L.

STATE OF KANSAS)
) SS
 COUNTY OF SEDGWICK)

Jerry A. Langrehr, Executive Vice President of Abercrombie Drilling, Inc.,
 does hereby state that the above and foregoing is a true and correct copy
 of the log of the SPRUILL "B" #1, E/2 SE NW, Section 19-19S-25W, Ness
 County, Kansas.

-ABERCROMBIE DRILLING, INC.

By: Jerry A. Langrehr
 Jerry A. Langrehr
 Executive Vice President

Subscribed and sworn to before me, a Notary Public, in and for the
 aforesaid county and state as of this 2nd day of April, 1975.

Nancy E. Haner
 Nancy E. Haner, Notary Public

Commission Expires: April 8, 1978

