

CARD MUST BE TYPED

State of Kansas

CARD MUST BE SIGNED

# NOTICE OF INTENTION TO DRILL

(see rules on reverse side)

Expected Spud Date... 3/7/88  
month day year

API Number 15— 051-24,546-0000

OPERATOR: License # 5663  
Name Hess Oil Company  
Address P.O. Box 905  
City/State/Zip McPherson, Kansas 64260

— East  
NW SW SW Sec. 31 Twp. 11S S, Rg. 19W W West  
990 Ft. from South Line of Section  
4950 Ft. from East Line of Section

(Note: Locate well on Section Plat on reverse side)

Contact Person... Jim Hess  
Phone... 241-4640 / 263-2243

Nearest lease or unit boundary line ... 330 feet  
County... Ellis

CONTRACTOR: License # 4958  
Name Mallard Joint Venture  
City/State... McPherson, Kansas 64260

Lease Name... Snider Well #... 1  
Ground surface elevation ... feet MSL

Well Drilled For: Well Class: Type Equipment:  
 Oil  Storage  Infield  Mud Rotary  
 Gas  Inj  Pool Ext.  Air Rotary  
 OWWO  Expl  Wildcat  Cable

Domestic well within 330 feet:  yes  no  
Municipal well within one mile:  yes  no  
Depth to bottom of fresh water... ~100  
Depth to bottom of usable water  
Surface pipe by Alternate: 1  2

If OWWO: old well info as follows:

Surface pipe planned to be set ... 160'  
Conductor pipe required ... NA  
Projected Total Depth ... 3750 feet  
Formation... Arbuckle

Operator  
Well Name  
Comp Date Old Total Depth

I certify that well will comply with K.S.A. 55-101, et seq., plus eventually plugging hole to KCC specifications.

Date 3/4/88 Signature of Operator or Agent Beth A. Cuh... Title Agent

For KCC Use:

Conductor Pipe Required ... feet; Minimum Surface Pipe Required ... 760 feet per Alt CD X2

This Authorization Expires 9-4-88 Approved By Per 3-4-88


EFFE DATE: 3-9-88

Must be filed with the K.C.C. five (5) days prior to commencing well  
This card void if drilling not started within six (6) months of date received by K.C.C.

**Important procedures to follow:**

1. Notify District office before setting surface casing.
2. Set surface casing by circulating cement to the top.
3. File completion forms ACO-1 with K.C.C. within 120 days of well spud date, following instructions on ACO-1, side 1, and including copies of wireline logs.
4. Notify District office 48 hours prior to old well workover or re-entry.
5. Prior to filing Intent, prepare a proposed plugging plan in case well is D & A, then obtain approval of plan when calling district office prior to setting surface pipe.
6. Submit plugging report (CP-4) to K.C.C. after plugging is completed.
7. Obtain an approved injection docket number before disposing of salt water.
8. Notify K.C.C. within 10 days when injection commences or terminates.

**A Regular Section of Land**  
1 Mile = 5,280 Ft.

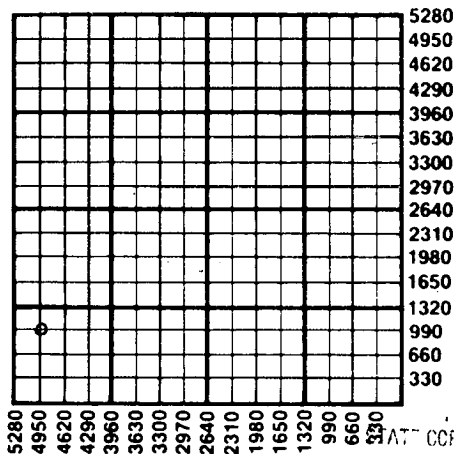

STATE CORPORATION COMMISSION

If an alternate 2 completion, cement in the production pipe from below any usable water to surface within 120 days of spud date.

**MAR 4 1988**  
CONSERVATION DIVISION  
Wichita, Kansas

State Corporation Commission of Kansas  
Conservation Division  
200 Colorado Derby Building  
Wichita, Kansas 67202-1212  
(316) 263-3238