

NOTICE OF INTENTION TO DRILL

(see rules on reverse side)

Starting Date 6 / 16 / 86 month day year

API Number 15- 135-23,035-00-00

OPERATOR: License # 5190 Name Sabre Exploration, Inc. Address 310 W. Central Suite 214 City/State/Zip Wichita, Kansas 67202 Contact Person Matt Totten Phone (316)-264-2635

C SW SW Sec. 2 Twp. 19 S, Rg. 25 West 660 Ft. from South Line of Section 4620 Ft. from East Line of Section

(Note: Locate well on Section Plat on reverse side)

CONTRACTOR: License # 9943 Name Republic Drilling, Inc. City/State Wichita, Kansas

Nearest lease or unit boundary line 660 feet County Ness

Lease Name Baldwin Well # 1

Ground surface elevation 2390 est. feet MSL

Well Drilled For: Well Class: Type Equipment: X Oil SWD Infield Mud Rotary Gas Inj Pool Ext Air Rotary OWWO Expl Wildcat Cable

Domestic well within 330 feet: yes X no

Municipal well within one mile: yes X no

Surface pipe by Alternate: 1 2 X

Depth to bottom of fresh water 200

Depth to bottom of usable water 800

Surface pipe planned to be set 250

Projected Total Depth 4400 feet

Formation Mississippian

If OWWO: old well info as follows:

Operator

Well Name

Comp Date Old Total Depth

I certify that well will comply with K.S.A. 55-101, et seq., plus eventually plugging hole to KCC specifications.

cementing will be done immediately upon setting production casing.

Date 6/10/86 Signature of Operator or Agent Matt Totten Title President

For KCC Use:

Conductor Pipe Required feet; Minimum Surface Pipe Required 220 feet per Alt.

This Authorization Expires 12-13-86 Approved By 6-13-86

RCA/KCC


Signature

Must be filed with the K.C.C. five (5) days prior to commencing well
This card void if drilling not started within six (6) months of date received by K.C.C.

Important procedures to follow:

1. Notify District office before setting surface casing.
2. Set surface casing by circulating cement to the top.
3. File completion forms ACO-1 with K.C.C. within 90 days of well completion, following instructions on ACO-1, side 1, and including copies of wireline logs.
4. Notify District office 48 hours prior to old well workover or re-entry.
5. Prior to filing Intent, prepare a proposed plugging plan in case well is D & A, then obtain approval of plan when calling district office prior to setting surface pipe.
6. Submit plugging report (CP-4) to K.C.C. after plugging is completed.
7. Obtain an approved injection docket number before disposing of salt water.
8. Notify K.C.C. within 10 days when injection commences or terminates.
9. If an alternate 2 completion, cement in the production pipe from below any usable water to surface within 120 days of spud date.

A Regular Section of Land 1 Mile = 5,280 Ft.

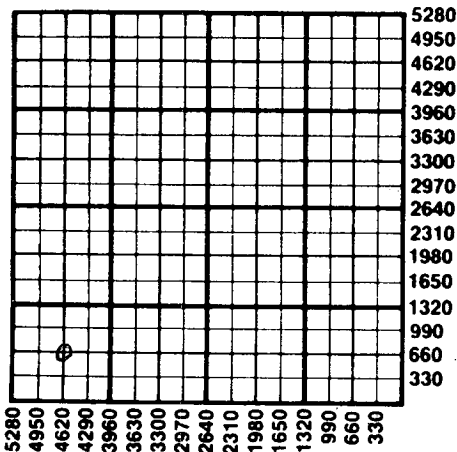

RECEIVED
STATE CORPORATION COMMISSION

JUN 13 1986
06-13-1986
CONSERVATION DIVISION
Wichita, Kansas

State Corporation Commission of Kansas
Conservation Division
200 Colorado Derby Building
Wichita, Kansas 67202
(316) 263-3238