


STATE OF KANSAS  
STATE CORPORATION COMMISSION

Give All Information Completely  
Make Required Affidavit  
Mail or Deliver Report to:  
Conservation Division  
State Corporation Commission  
212 North Market, Insurance Bldg.  
Wichita, Kansas

WELL PLUGGING RECORD

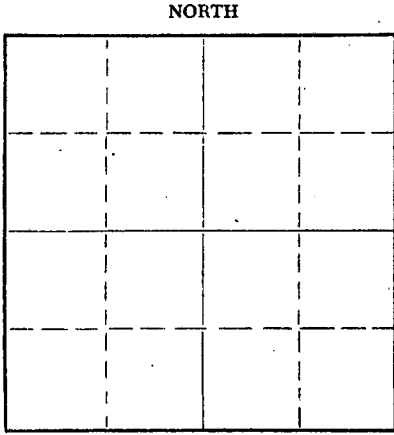

Locate well correctly on above  
Section Plat

Ellis County, Sec. 7 Twp. 11S Rge. 18E (E) (W)  
Location as "NE/CNW%SW%" or footage from lines C SW SW  
Lease Owner Davis Bros. - Transit Corporation  
Lease Name Richards "A" Well No. 1  
Office Address 1516 Liberty Bank Bldg., Oklahoma City, Oklahoma  
Character of Well (completed as Oil, Gas or Dry Hole) Dry Hole  
Date well completed March 2 19 61  
Application for plugging filed March 2 19 61  
Application for plugging approved March 2 19 61  
Plugging commenced March 2 19 61  
Plugging completed March 2 19 61  
Reason for abandonment of well or producing formation No production

If a producing well is abandoned, date of last production 19  
Was permission obtained from the Conservation Division or its agents before plugging was commenced? Yes

Name of Conservation Agent who supervised plugging of this well Eldon Petty, Box 326, Hays, Kansas  
Producing formation \_\_\_\_\_ Depth to top \_\_\_\_\_ Bottom \_\_\_\_\_ Total Depth of Well \_\_\_\_\_ Feet  
Show depth and thickness of all water, oil and gas formations.

OIL, GAS OR WATER RECORDS

CASING RECORD

FORMATION	CONTENT	FROM	TO	SIZE	PUT IN	PULLED OUT
				8 5/8"	184'	None

Describe in detail the manner in which the well was plugged, indicating where the mud fluid was placed and the method or methods used in introducing it into the hole. If cement or other plugs were used, state the character of same and depth placed, from \_\_\_\_\_ feet to \_\_\_\_\_ feet for each plug set.

Filled hole with heavy drilling mud and squeezed in 100 sacks of pozmix and pressured to 400 pounds

**RECEIVED**  
STATE CORPORATION COMMISSION  
MAR 28 1961  
CONSERVATION DIVISION  
Wichita, Kansas

(If additional description is necessary, use BACK of this sheet)  
Name of Plugging Contractor Transit Corporation  
Address 1516 Liberty Bank Bldg., Oklahoma City, Oklahoma

STATE OF Oklahoma COUNTY OF Oklahoma, ss.  
Paul E. Gathers (employee of owner) or (owner or operator) of the above-described well, being first duly sworn on oath, says: That I have knowledge of the facts, statements, and matters herein contained and the log of the above-described well as filed and that the same are true and correct. So help me God.


(Signature) Paul E. Gathers

(Address)

SUBSCRIBED AND SWORN to before me this 27th day of March, 19 61

My commission expires March 10, 1965

Eldon M. Anderson  
Notary Public.

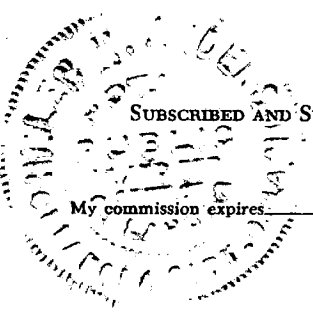

**RECEIVED**  
STATE CORPORATE COMMISSION

MAR 28 1961

CONSERVATION DIVISION  
Wichita, Kansas

**DRILLER'S WELL LOG**

Davis Bros. - Transit Corporation - Richards "A" # 1 well located in  
C SW SW Section 7-11S-18W.  
Ellis County, Kansas

Commenced: February 21, 1961  
Completed: March 2, 1961  
Elevation: 1952' K. B.

Casing: 8 5/8" @ 184'  
Cemented w/115 sacks

<u>Formation</u>	<u>From</u>	<u>To</u>	<u>Summary of Formation</u>	
Clay	0	45		
Sand	45	70	Anhydrite	1303'
Shale	70	345	Topeka	2946'
Shale and clay	345	411	Heebner	3170'
Sand	411	510	Toronto	3185'
Shale and shells	510	750	Lansing	3211'
Sand	750	975	Base of Kansas City	3445'
Shale	975	1080	Conglomerate	3456'
Redbed	1080	1314	Simpson Shale	3510'
Anhydrite	1314	1332	Simpson Dolomite	3516'
Shale	1332	1865	Arbuckle	3537'
Salt	1865	1880		
Lime and shale	1880	2385		
Salt	2385	2400		
Lime and shale	2400	3005		
Lime	3005	3140		
Lime and shale	3140	3211		
Lime	3211	3277		
Lime and shale	3277	3320		
Lime	3320	3405		
Lime and shale	3405	3450		
Conglomerate chert	3450	3510		
Conglomerate	3510	3545		
Arbuckle	3545	3587 T. D.		

I hereby certify the foregoing to be a true and accurate Driller's Log of the formation encountered in the above well.

Subscribed and sworn to before me,  
this 27th of March, 1961

TRANSIT CORPORATION

By Paul C. Gardner

My commission expires March 10, 1965

Debra M. Anderson  
Notary Public