


STATE OF KANSAS
STATE CORPORATION COMMISSION
CONSERVATION DIVISION
P. O. BOX 17027
WICHITA, KANSAS 67217

FORM CP-4

WELL PLUGGING RECORD

NORTH

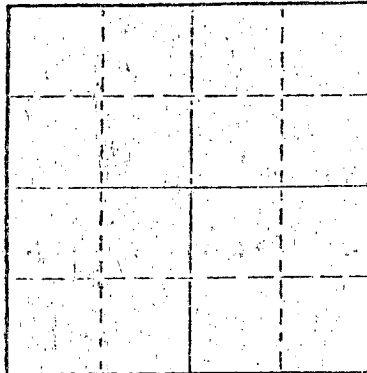

Locate well correctly on above
Section Plat

Ellis County. Sec. 16 Twp. 11 Rge. 18 (E) W (W)

Location as "NE/CNW/SW" or footage from lines SE SE NE

Lease Owner Shields Oil Producers, Inc.

Lease Name Madden "A"

Well No. 1

Office Address Shields Bldg., Russell, Kansas 67665

Character of Well (completed as Oil, Gas or Dry Hole) Dry hole

Date well completed July 20 1978

Application for plugging filed July 20 1978

Application for plugging approved July 20 1978

Plugging commenced July 20 1978

Plugging completed July 20 1978

Reason for abandonment of well or producing formation Dry hole

If a producing well is abandoned, date of last production 19

Was permission obtained from the Conservation Division or its agents before plugging was commenced? Yes

Name of Conservation Agent who supervised plugging of this well Leo Massey

Producing formation Depth to top Bottom Total Depth of Well 3,201 Feet

Show depth and thickness of all water, oil and gas formations.

OIL, GAS OR WATER RECORDS

CASING RECORD

FORMATION	CONTENT	FROM	TO	SIZE	PUT IN	PULLED OUT
				8 5/8"	1,193'	Cmtd. w/450 sax

Describe in detail the manner in which the well was plugged, indicating where the mud fluid was placed and the method or methods used in introducing it into the hole. If cement or other plugs were used, state the character of same and depth placed, from feet to feet for each plug set.

Fill hole w/heavy mud

Push bridge plug to 450'

Push bridge plug to 40' w/ 1/2 sax hulls on plug

Dump 10 sax cement on plug to cellar

Dump 2 sax cement in rat hole and mouse hole

(If additional description is necessary, use BACK of this sheet)

Name of Plugging Contractor Shields Drilling Co., Inc.

Address Shields Bldg., Russell, Kansas 67665

STATE OF KANSAS

COUNTY OF RUSSELL

ss.

R.L. Shields

(owner or operator)

well, being first duly sworn on oath, says: That I have knowledge of the facts, statements, and matters herein contained and the log of the above-described well as filed and that the same are true and correct. So help me God.

(Signature)

R.L. Shields

Shields Bldg., Russell, Kansas

(Address)

Subscribed and sworn to before me this 31st

day of July

1978



Rich Phillips

Notary Public.

RECEIVED
STATE CORPORATION COMMISSION
AUG 02 1978
CONSERVATION DIVISION
Wichita, Kansas



Shields


15051-21515-0000

Russell, Kansas

WELL LOG

Operator: Shields Oil Producers, Inc.
Well: Madden "A" #1
Commenced: July 14, 1978
Completed: July 20, 1978
Contractor: Shields Drilling Co., Inc.

Well Description: SE SE NE "
Sec. 16-11S-18W
Ellis Co., Kansas

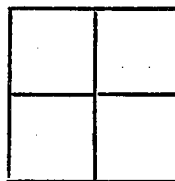

Elevation: 1,891' KB
Treatment:
Production: D & A
Tops:

CASING RECORD

Size	Run	Pulled
8 5/8"	1,193'	Cmtd. w/450 sax

..... Figures Indicate Bottom of Formations

Top soil & sand	45'
Shale & sand	436'
Shale & shells	460'
Sand	575'
Shale & sand	909'
Redbed	1,184'
Anhydrite	1,219'
Shale	1,790'
Shale & lime	2,725'
Shale	2,855'
Lime & shale	2,995'
Lime	3,201' RTD

RECEIVED
STATE CORPORATION COMMISSION

AUG 02 1978

CONSERVATION DIVISION
Wichita, Kansas

Notes