


WELL PLUGGING RECORD

Give All Information Completely
Make Required Affidavit
Mail or Deliver Report to:
Conservation Division
State Corporation Commission
212 North Market, Insurance Bldg.
Wichita, Kansas

Ellis County, Sec. 16 Twp. 11S Rge. 18 (E) W (W)

Location as "NE/CNW/SW" or footage from lines NW NW SW
Lease Owner Robinowitz Oil Company
Lease Name Wasinger Well No. 1
Office Address 311 Shell Building, Tulsa, Oklahoma
Character of Well (completed as Oil, Gas or Dry Hole) dry hole
Date well completed June 20 1960
Application for plugging filed June 20 1960
Application for plugging approved June 20 1960
Plugging commenced June 20 1960
Plugging completed June 20 1960
Reason for abandonment of well or producing formation dry hole

NORTH

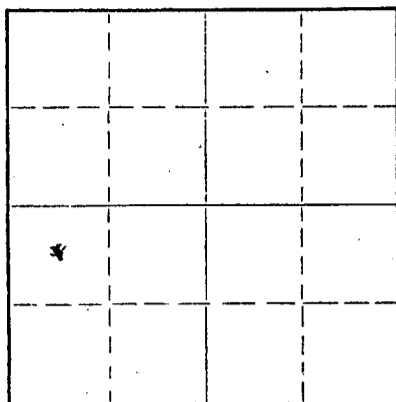

Locate well correctly on above
Section Plat

If a producing well is abandoned, date of last production _____ 19____
Was permission obtained from the Conservation Division or its agents before plugging was commenced? _____

Name of Conservation Agent who supervised plugging of this well Eldon Petty
Producing formation _____ Depth to top _____ Bottom _____ Total Depth of Well 3500 Feet
Show depth and thickness of all water, oil and gas formations.

OIL, GAS OR WATER RECORDS

CASING RECORD

FORMATION	CONTENT	FROM	TO	SIZE	PUT IN	PULLED OUT
Surface Pipe		-0-	1037'	8 5/8"	1037'	-0-

Describe in detail the manner in which the well was plugged, indicating where the mud fluid was placed and the method or methods used in introducing it into the hole. If cement or other plugs were used, state the character of same and depth placed, from _____ feet to _____ feet for each plug set.

Filled hole with heavy mud to 450'
Set plug at 450 with 1/4 sack hulls and 20 sacks cement thru DP.
Filled hole with heavy mud to 180'
Set plug at 180' with 1/4 hulls and 20 sacks cement thru DP.
Filled hole with heavy mud to 40'.
Set plug at 40' with 10 sacks cement.

RECEIVED
STATE CORPORATION COMMISSION

JUL 22 1960

CONSERVATION DIVISION
Wichita, Kansas

(If additional description is necessary, use BACK of this sheet)
Name of Plugging Contractor A. L. Jackson Drilling Company
Address Box 194, Great Bend, Kansas


STATE OF Kansas, COUNTY OF Barton, ss.
C. L. Miles, contractor on _____ (employee of owner) or (owner or operator) of the above-described well, being first duly sworn on oath, says: That I have knowledge of the facts, statements, and matters herein contained and the log of the above-described well as filed and that the same are true and correct. So help me God.

(Signature) C. L. Miles
Box 194, Great Bend, Kansas
(Address)

SUBSCRIBED AND SWORN to before me this 24th day of June, 1960

My commission expires April 27, 1961

Virgil F. [Signature]
Notary Public.

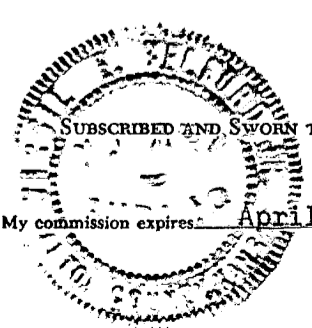

WELL LOG
 Wasinger # 1
 NW NW SW 16-11S-18W
 Ellis County, Kansas

0 - 420	Post rock, shale & shells	Elevation	1889 DF
420 - 490	Shale		
490 - 695	Sand streaks	Topeka	2883
695 - 875	Sand	Heebner	3109
875 - 935	Red bed	Toronto	3126
935 - 1037	Red bed, & broken anhydrite	Lansing	3149
1037 - 1195	Red bed	Conglomerate	3407
1195 - 1235	Anhydrite	Simpson	3451
1235 - 1330	Shale & shells	Arbuckle	3487
1330 - 1850	Shale		
1850 - 1895	Lime & shale		
1895 - 2050	Lime & shale		
2050 - 2410	Lime		
2410 - 2435	Lime & shale		
2435 - 2900	Shale		
2900 - 2964	Lime & shale		
2964 - 3045	Lime & broken shale		
3045 - 3500	Lime		

STATE OF KANSAS
 COUNTY OF BARTON ss

C. L. Miles, d/b/a A. L. Jackson Drilling Company, being first duly sworn on oath says: That I have knowledge of the facts, statements and matters herein contained and the log of the above described well as filed and that the same are true and correct.


 C. L. Miles

Subscribed and sworn before me this 24 day of July, 1960


 Notary Public Barton County



RECEIVED
 STATE CORPORATION COMMISSION

JUL 22 1960

CONSERVATION DIVISION