


STATE OF KANSAS
STATE CORPORATION COMMISSION

WELL PLUGGING RECORD

Give All Information Completely
Make Required Affidavit
Mail or Deliver Report to
Conservation Division
State Corporation Comm.
245 North Water
Wichita, KS 67202

Ellis County, Sec. 18 Twp. 11S Rge. 18 E/W
Location as "NE/CNW $\frac{1}{4}$ SW $\frac{1}{4}$ " or footage from lines
NE/4 NE/4 SE/4

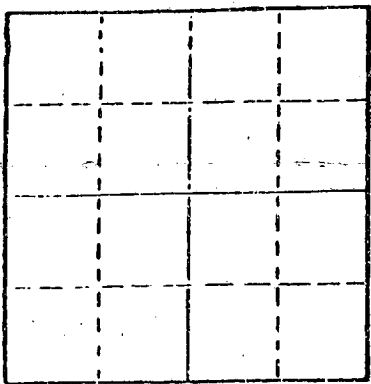

Locate well correctly on above
Section Plot

Lease Owner Robert R. Price Operating, Inc.
Lease Name Frisbie Well No. #1-E
Office Address Box 45442, Tulsa, Oklahoma 74145
Character of Well (Completed as Oil, Gas or Dry Hole)
Dry Hole

Date Well completed 7-9 19 82
Application for plugging filed 7-9 19 82
Application for plugging approved 7-9 19 82
Plugging commenced 7-9 19 82
Plugging completed 7-9 19 82
Reason for abandonment of well or producing formation
Dry Hole

If a producing well is abandoned, date of last production
19

Was permission obtained from the Conservation Division or
its agents before plugging was commenced? yes

Name of Conservation Agent who supervised plugging of this well Gilbert Scheck
Producing formation _____ Depth to top _____ Bottom _____ Total Depth of Well _____
Show depth and thickness of all water, oil and gas formations.

OIL, GAS OR WATER RECORDS

CASING RECORD

FORMATION	CONTENT	FROM	TO	SIZE	PUT IN	PULLED OUT
				8-5/8"	94'	-0-

Describe in detail the manner in which the well was plugged, indicating where the mud fluid
was placed and the method or methods used in introducing it into the hold. If cement or other
plugs were used, state the character of same and depth placed, from _____ feet to
_____ feet for each plug set.

Mud laden fluid 2196' to 720'
80 sx cement @ 720'
40 sx cement @ 150'
10 sx cement @ 40'
10 sx cement in Rat Hole

(If additional description is necessary, use BACK of this sheet)

Name of Plugging Contractor Ranger Drilling Company, Inc.

STATE OF KANSAS COUNTY OF ELLIS, ss.
Jay C. Boyer (employee of owner) or (owner or operator)


of the above-described well, being first duly sworn on oath, says: That I have knowledge of
the facts, statements, and matters herein contained and the log of the above-described well
as filed and that the same are true and correct. So help me God.

(Signature) Jay C. Boyer mlk
P.O. Box 856, Hays, Kansas 67601
(Address)

SUBSCRIBED AND SWORN TO before me this 14th day of July, 1982

Mary L. Kehm
Notary Public.

My commission expires 8-6-85

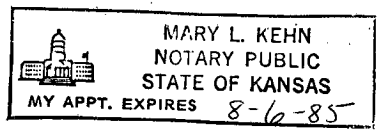

RECEIVED
STATE CORPORATION COMMISSION

JUL 16 1982

CONSERVATION DIVISION
Wichita, Kansas

