


STATE OF KANSAS
STATE CORPORATION COMMISSION

1505/00345-0000

Give All Information Completely
Make Required Affidavit
Mail or Deliver Report to:
Conservation Division
State Corporation Commission
211 No. Broadway
Wichita, Kansas

WELL PLUGGING RECORD

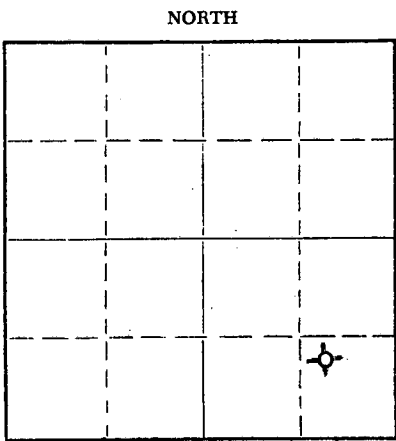

Locate well correctly on above
Section Plat

Ellis County, Sec. 18 Twp. 11 Rge. 18W (E) (W)
Location as "NE/CNW/SW" or footage from lines. NW SE SE
Lease Owner C-G Drilling Co.
Lease Name Rogers Well No. 1
Office Address 107 Rule Building, Wichita, Kansas
Character of Well (completed as Oil, Gas or Dry Hole) Dry Hole
Date well completed January 11 19 59
Application for plugging filed January 11 19 59
Application for plugging approved January 11 19 59
Plugging commenced January 11 19 59
Plugging completed January 11 19 59
Reason for abandonment of well or producing formation Too low structurally

If a producing well is abandoned, date of last production 19
Was permission obtained from the Conservation Division or its agents before plugging was commenced? Yes

Name of Conservation Agent who supervised plugging of this well Eldon Petty, Hays, Kansas
Producing formation Depth to top Bottom Total Depth of Well 3582 Feet
Show depth and thickness of all water, oil and gas formations.

OIL, GAS OR WATER RECORDS

CASING RECORD

FORMATION	CONTENT	FROM	TO	SIZE	PUT IN	PULLED OUT
				8-5/8"	1281'	none

Describe in detail the manner in which the well was plugged, indicating where the mud fluid was placed and the method or methods used in introducing it into the hole. If cement or other plugs were used, state the character of same and depth placed, from feet to feet for each plug set.

Filled hole with heavy mud to 400'. Set plug. Put in 20 sacks cement. Filled to 300'. Set plug. Put in 1/4 sack hulls and 20 sacks cement. Filled with heavy mud up to 40'. Set plug. Filled to top with 1/2 sack hulls and 10 sacks cement.

RECEIVED
STATE CORPORATION COMMISSION

FEB 10 1959

CONSERVATION DIVISION
Wichita, Kansas

(If additional description is necessary, use BACK of this sheet)

Name of Plugging Contractor C-G Drilling Co.
Address 107 Rule Building, Wichita, Kansas

STATE OF KANSAS, COUNTY OF SEDGWICK, ss.
G. F. Galloway (employee of owner) or (owner or operator) of the above-described well, being first duly sworn on oath, says: That I have knowledge of the facts, statements, and matters herein contained and the log of the above-described well as filed and that the same are true and correct. So help me God.

(Signature) G. F. Galloway
107 Rule Building
(Address)



14th day of January, 1959
Vicky Jacobs
Notary Public.

PLUGGING
FILE SEC 18 T 11 R 18W
BOOK PAGE 11 LINE 28

W E L L L O G

OPERATOR C-G Drilling Co. SEC. 18-11-18W
 WELL NAME Rogers #1 LOC. NW SE SE
 TOTAL DEPTH 3582' COUNTY Ellis
 COMM. December 31, 1958 COMP. January 11, 1959 STATE Kansas
 RIG NO. 2 ELEVATION 1947' K.B.
 CASING: Ran 1281' (60jts.) 8-5/8" OD Surface Casing. PRODUCTION: D&A

All measurements taken from the top of rotary bushing.

FROM	TO	FORMATION	DEVIATION FROM VERTICAL	REMARKS:
0	1005	Shale-Sand		
1005	1010	Shale-Shell		
1010	1274	Red Bed		
1274	1312	Anhydrite.	0° - 2500	
1312	2110	Shale-Shell	0° - 2750	
2110	3056	Shale-Lime	0° - 3000	
3056	3582	Lime	0° - 3250	

RECEIVED
 STATE CORPORATION COMMISSION
 FEB 10 1959
 CONSERVATION DIVISION
 Wichita, Kansas

STATE OF KANSAS }
 COUNTY OF SEDGWICK } SS.

The undersigned hereby certifies that to the best of his knowledge and belief, the above facts are true and correct.

C-G DRILLING CO.
 By V. F. Galloway
 V. F. Galloway

SUBSCRIBED AND SWORN TO, BEFORE ME, THIS 14th day of January, 1959.
 My commission expires: May 20, 1959
Vicky Jacobs
 Vicky Jacobs - Notary public



PLUGGING
 FILE SEC. 18 T. 11 R. 18W
 BOOK PAGE 11 LINE 20