

STATE OF KANSAS
STATE CORPORATION COMMISSION


WELL PLUGGING RECORD

OR
FORMATION PLUGGING RECORD

Strike out upper line when reporting plugging of formations.

Give All Information Completely
Make Required Affidavit
Mail or Deliver Report to:
Conservation Division
State Corporation Commission
800 Bitting Building
Wichita, Kansas

NORTH

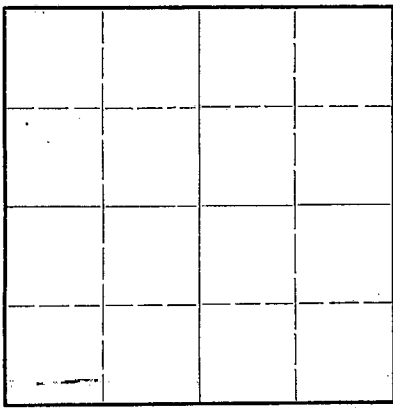

Locate well correctly on above Section Plat

Ellis County. Sec. 14 Twp. 11S Rge. 18 (E) (W)
Location as "NE 1/4 NW 1/4 SW 1/4" or footage from lines NW/4 NW/4 NW/4
Lease Owner Lario Oil & Gas Company
Lease Name Conrad Well No. 1
Office Address 301 South Market, Wichita, Kansas
Character of Well (completed as Oil, Gas or Dry Hole) Dry Hole
Date well completed November 21, 19 47
Application for plugging filed November 21, 19 47
Application for plugging approved November 21, 19 47
Plugging commenced November 21, 19 47
Plugging completed November 21, 19 47
Reason for abandonment of well or producing formation Dry Hole

If a producing well is abandoned, date of last production none 19
Was permission obtained from the Conservation Division or its agents before plugging was commenced? Yes

Name of Conservation Agent who supervised plugging of this well C. D. Stough
Producing formation Depth to top Bottom Total Depth of Well 3526 Feet
Show depth and thickness of all water, oil and gas formations.

OIL, GAS OR WATER RECORDS

CASING RECORD


Formation	Content	From	To	Size	Put In	Pulled Out
				8 5/8"	1170'	None

Describe in detail the manner in which the well was plugged, indicating where the mud fluid was placed and the method or methods used in introducing it into the hold. If cement or other plugs were used, state the character of same and depth placed, from feet to feet for each plug set.

Drove plug to bottom of surface pipe, HOWCO spotted 15 sacks cement, drove plug to 200' spotted 15 sacks cement, spotted plug at 30'. Filled hole to top with cement.

(If additional description is necessary, use BACK of this sheet)

Correspondence regarding this well should be addressed to Lario Oil & Gas Company
Address 301 South Market
Wichita, Kansas

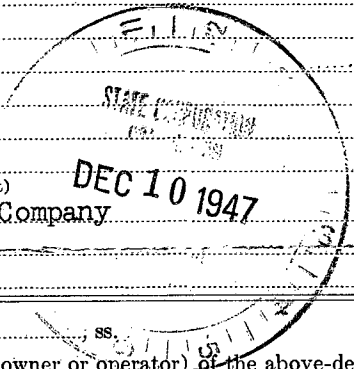

STATE OF Kansas, COUNTY OF Sedgwick
Leo Ross (employee of owner) or (owner or operator) of the above-described well,

being first duly sworn on oath, says: That I have knowledge of the facts, statements, and matters herein contained and the log of the above-described well as filed and that the same are true and correct. So help me God.

(Signature) By Lario Oil & Gas Company
301 South Market, Wichita, Kansas
(Address)

SUBSCRIBED AND SWORN to before me this 9th day of December, 1947.
Mercedes Dobbins
Notary Public.

My commission expires Dec 27, 1949.

PLUGGING
FILE SEC 14 T 11 R 14 W
BOOK PAGE 1 LINE 10

COMPANY: LARIO OIL & GAS COMPANY
 CONTRACTOR: MURFIN DRILLING COMPANY
 FARM: CONRAD NO. 1
 LOCATION: NW NW NW
 Sec. 14-11S-18W
 Ellis County, Kansas
 COMMENCED: 11-5-47
 COMPLETED: 11-21-47
 PRODUCTION: DRY

CASING: 8 5/8" 1170 Cem. 550 sacks.

<u>FORMATION</u>	<u>DEPTH</u>	<u>TOPS:</u>
Shale & Sand	60	Topeka 2860
Shale & Shells	405	Lansing 3128
Shale & Sand	545	Simpson 3450
Iron	590	Arbuckle 3473
Shale & Shells	970	T.D. 3526
Red Bed	1151	
Anhydrite	1195	
Shale & Shells	1365	All tops corrected to derrick floor
Shale	1515	
Shale & Shells	1600	
Salt & Shale	1775	
Shale & Shells	1840	
Shale & Lime	2015	
Lime	2085	
Lime & Shale	2155	
Lime	2210	
Lime & Shale	2415	
Lime Broken	2465	
Lime	2635	
Shale & Shells	2655	
Lime	2685	
Lime & Shale	2845	
Shale	2860	
Lime	2900	
Lime & Shale	2945	
Lime	3085	
Lime & Shale	3120	
Lime	3155	
Lime & Shale	3205	
Lime	3375	
Conglomerate-chert	3420	
Shale	3435	
Arbuckle	3473	
Lime	3510	
Lime & Chert	3526	
T.D.	3526	

PLUGGING
 FILE SEC 14 T 11 R 18W
 BOOK PAGE 1 LINE 10

