


STATE OF KANSAS
STATE CORPORATION COMMISSION

Give All Information Completely
Make Required Affidavit
Mail or Deliver Report to:
Conservation Division
State Corporation Commission
800 Bitting Building
Wichita, Kansas

WELL PLUGGING RECORD

Ellis County, Sec. 14 Twp. 11S. Rge. (E) 18 (W)
Location as "NE/CNW 1/4 SW 1/4" or footage from lines NE NW NE
Lease Owner SHELL OIL COMPANY
Lease Name B. A. DEANE Well No. 3
Office Address Box 744, Great Bend, Kansas
Character of Well (completed as Oil, Gas or Dry Hole) Oil
Date well completed September 22 1941
Application for plugging filed December 9 1949
Application for plugging approved December 7 1949
Plugging commenced November 10 1949
Plugging completed November 12 1949
Reason for abandonment of well or producing formation Oil Depleted

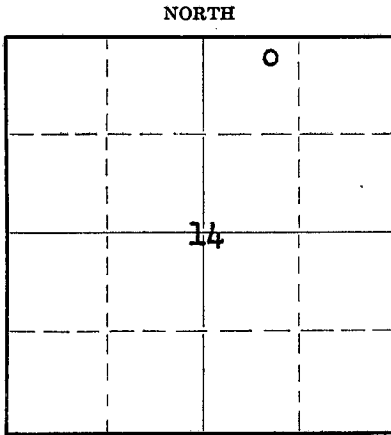

Locate well correctly on above
Section Plat

If a producing well is abandoned, date of last production May 23 1949
Was permission obtained from the Conservation Division or its agents before plugging was commenced? Yes

Name of Conservation Agent who supervised plugging of this well Eldon Petty
Producing formation Arbuckle Depth to top 3409 Bottom Total Depth of Well 3418 Feet
Show depth and thickness of all water, oil and gas formations. 3161 PB

OIL, GAS OR WATER RECORDS

CASING RECORD

Formation	Content	From	To	Size	Put In	Pulled Out
Arbuckle	I.P. 8381 oil & o water	3410	3411	13" 8 5/8" 4 1/2"	84' 1152' 3410'	None None 2800'
Lans.Kans.City	3/4 bbl salt water/hour 15 hours, swab.	3130	3138			

Describe in detail the manner in which the well was plugged, indicating where the mud fluid was placed and the method or methods used in introducing it into the hole. If cement or other plugs were used, state the character of same and depth placed, from feet to feet for each plug set.

Rock hole to 3100'. Ran 4 sax cement -
filled to 3040'. Mudded hole to 250'. Ran
20 sax cement. Mudded hole to 40'. Ran 10
sax cement.

(If additional description is necessary, use BACK of this sheet)

Correspondence regarding this well should be addressed to Shell Oil Company
Address c/o S. S. Mabry, Box 744, Great Bend, Kansas

STATE OF KANSAS, COUNTY OF BARTON, ss.

S. S. Mabry (employee of owner) or (owner) of the above-described well,
being first duly sworn on oath, says: That I have knowledge of the facts, statements, and matters herein contained and the log of the above-described well as filed and that the same are true and correct. So help me God.


(Signature)

Box 744, Great Bend, Kansas
(Address)

SUBSCRIBED AND SWORN to before me this 9th day of December, 1949

My commission expires

January 24, 1953

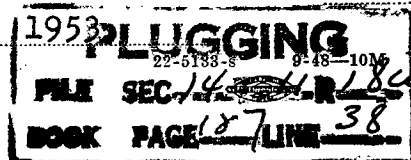

Notary Public

Shell-B. A. Deane #3
 NE NW NE 14-11S-18W
 Burnett Pool
 Ellis County, Kansas

Casing Record

13" cem 84 with 75 sax
 8 5/8" cem 1152 with 325 sax & 12 Aquagel
 4 1/2" cem 3410 with 100 sax; perforated
 3130-38.

0 - 280 sand & shale
 310 shale
 385 sand
 430 shale & red bed
 800 sand & pyrite
 1035 shale
 1146 shale & red bed
 1185 anhydrite
 1270 shale & red bed
 1450 shale
 1495 shale & lime shells
 1535 salt
 1675 salt & shale
 2035 shale & lime
 2110 lime & shale broken
 2550 lime & shale
 2645 lime & shale breaks
 2710 shale
 2815 shale & lime
 2834 shale Top Topeka 2833
 2892 lime
 2962 lime & shale
 3251 lime Top Lansing-Kansas City 3132
 3360 lime & shale
 3389 conglomerate
 Top Sooy 3360
 3396 dolomite
 Top Simpson Dolomite 3389
 3409 shale
 Top Simpson Shale 3396
 Simpson Sand - trace.
 3411 dolomite TD
 3418 dolomite (deepened) TD
 Note: Lost Dowell plastic
 dump bailer in hole; not
 recovered.
 3161 PB

