


STATE OF KANSAS
STATE CORPORATION COMMISSION

WELL PLUGGING RECORD

Give All Information Completely
Make Required Affidavit
Mail or Deliver Report to
Conservation Division
State Corporation Comm.
245 North Water
Wichita, KS 67202

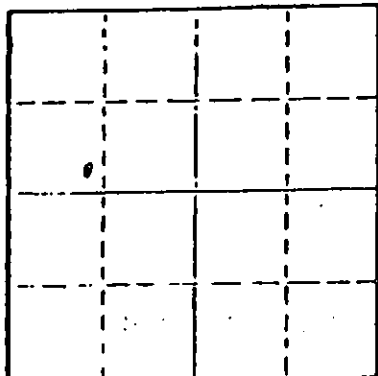

Locate well correctly on above
Section Plot

Ness County. Sec. 18 Twp. 17S Rge. 26W E/W
Location as "NE/CNW $\frac{1}{4}$ SW $\frac{1}{4}$ " or footage from lines

SE SW NW
Lease Owner Mull Drilling Co.
Lease Name Johnson Well No. 1
Office Address 415 Page Court, 220 W. Douglas, Wichita, Ks.
Character of Well (Completed as Oil, Gas or Dry Hole)

Dry Hole
Date Well completed 6-25 19 77
Application for plugging filed 6-25 19 77
Application for plugging approved 6-25 19 77
Plugging commenced 6-25 19 77
Plugging completed 6-25 19 77
Reason for abandonment of well or producing formation

D & A
If a producing well is abandoned, date of last production 19

Was permission obtained from the Conservation Division or
its agents before plugging was commenced? Yes

Name of Conservation Agent who supervised plugging of this well Leo Massey
Producing formation Depth to top Bottom Total Depth of Well
Show depth and thickness of all water, oil and gas formations.

OIL, GAS OR WATER RECORDS

CASING RECORD

FORMATION	CONTENT	FROM	TO	SIZE	PUT IN	PULLED OUT
Surface pipe		0	286'	8 5/8"	286'	None

Describe in detail the manner in which the well was plugged, indicating where the mud fluid was placed and the method or methods used in introducing it into the hold. If cement or other plugs were used, state the character of same and depth placed, from feet to feet for each plug set.

Filled hole with heavy mud.

#1 Plug set @ 720' with 70 sks. cement.

#2 Plug set @ 240' with 20 sks. cement.

#3 Plug set @ 40' with 10 sks. cement.

RECEIVED
STATE CORPORATION COMMISSION
JUL 05 1977
CONSERVATION DIVISION
Wichita, Kansas

(If additional description is necessary, use BACK of this sheet)

Name of Plugging Contractor Blue Goose Drilling Co., Inc.
Box 1413, Great Bend, Kansas 67530

STATE OF Kansas COUNTY OF Barton ss.
George E. Miller, Jr.


(Signature) or (owner or operator) of the above-described well, being first duly sworn on oath, says: That I have knowledge of the facts, statements, and matters herein contained and the log of the above-described well as filed and that the same are true and correct. So help me God.

(Signature) George E. Miller, Jr.
Box 1413, Great Bend, Kansas 67530
(Address)

Subscribed and Sworn to before me this 30th day of June, 1977

My commission expires 7-10-77

Mary Ann Schwanborn
Notary Public.

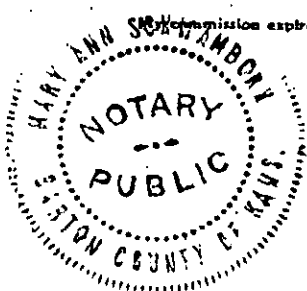

15-135-21339-0000

WELL LOG
Johnson #1
SE SW NW 18-17S-26W
Ness County, Kansas

Name of Operator: Mull Drilling Co., Inc.
415 Page Court, 220 W. Douglas
Wichita, Kansas 67202

Date Completed: June 25, 1977

FROM	TO	
0	1920	Sand and shale
1920	1930	Shale
1930	1960	Anhydrite
1960	3190	Shale and shells
3190	3455	Shale and lime
3455	3580	Shale and shells
3580	3740	Lime and shale
3740	3925	Lime
3925	4160	Shale and lime
4160	4295	Lime
4295	4410	Lime and shale
4410	4530	Lime
4530		Total Depth

STATE OF KANSAS

COUNTY OF BARTON

George E. Miller, Jr., President of Blue Goose Drilling Co., Inc.,
being first duly sworn on oath says: That I have knowledge of the facts, statements
and matters herein contained and the log of the above described well as filed
and that the same are true and correct.

RECEIVED
STATE COMMISSIONER OF LANDS
JUL 05 1977
CONSERVATION DIVISION
Wichita, Kansas

George E. Miller, Jr.
George E. Miller, Jr.

Subscribed and sworn before me this 30th day of June, 1977.

Mary Ann Schwamborn
Notary Public Barton County

My Commission Expires 7-10-77

