

15-135-00295-00-00

STATE OF KANSAS
STATE CORPORATION COMMISSION

WELL PLUGGING RECORD

Give All Information Completely
Make Required Affidavit
Mail or Deliver Report to:
Conservation Division
State Corporation Commission
800 Bitting Building
Wichita, Kansas

OR

FORMATION PLUGGING RECORD

Strike out upper line
when reporting plug-
ging off formations.

Ness County. Sec. 23 Twp. 17S Rge. (E) 26 (W)

Location as "NE 1/4 NW 1/4 SW 1/4" or footage from lines NW/4 NW/4 NW/4

Lease Owner Skelly Oil Company

Lease Name Tom Norton Well No. 1

Office Address Box 391, Hutchinson, Kansas

Character of Well (completed as Oil, Gas or Dry Hole) Oil

Date well completed August 24 1944

Application for plugging filed June 5 1947

Application for plugging approved June 6 1947


Plugging commenced July 17 1947

Plugging completed July 23 1947

Reason for abandonment of well or producing formation Depleted oil well.

If a producing well is abandoned, date of last production April 1 1947

Was permission obtained from the Conservation Division or its agents before plugging was commenced? Yes

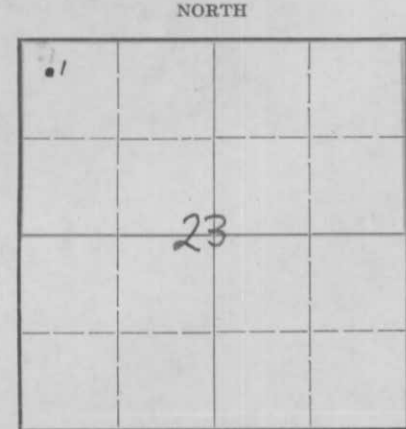

Locate well correctly on above
Section Plat

Name of Conservation Agent who supervised plugging of this well H. W. Kerr

Producing formation Mississippi Line Depth to top 4449' Bottom 4461' Total Depth of Well 4461 Feet

Show depth and thickness of all water, oil and gas formations.


OIL, GAS OR WATER RECORDS

CASING RECORD

Formation	Content	From	To	Size	Put In	Pulled Out
Mississippi Line	Oil	4449'	4461'	13-3/8"	237'	None
				8-5/8"	1265'-5"	None
				5-1/2"	4485'-0"	2645'-2"

Describe in detail the manner in which the well was plugged, indicating where the mud fluid was placed and the method or methods used in introducing it into the hold. If cement or other plugs were used, state the character of same and depth placed, from.....feet to.....feet for each plug set.

6 sacks cement 4461' to 4410'
Mud laden fluid 4410' to 250'
15 sacks cement 250' to 205'
Mud laden fluid 205' to 15'
10 sacks cement 15' to 6'
Surface soil 6' to 0'

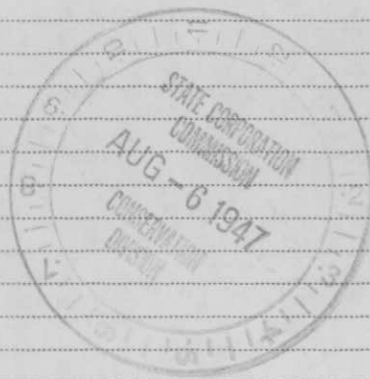

(If additional description is necessary, use BACK of this sheet)

Correspondence regarding this well should be addressed to Skelly Oil Company

Address Box 391, Hutchinson, Kansas

STATE OF Kansas COUNTY OF Reno, ss.

H. E. Wamsley (employee of owner) or (owner or operator) of the above-described well,

being first duly sworn on oath, says: That I have knowledge of the facts, statements, and matters herein contained and the log of the above-described well as filed and that the same are true and correct. So help me God.

(Signature) [Signature]


Box 391, Hutchinson, Kansas

(Address)


SUBSCRIBED AND SWORN to before me this 1st day of August, 1947

My commission expires April 7, 1951

Josephine L. Johnson Notary Public.

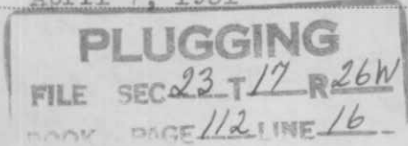

SKELLY OIL COMPANY

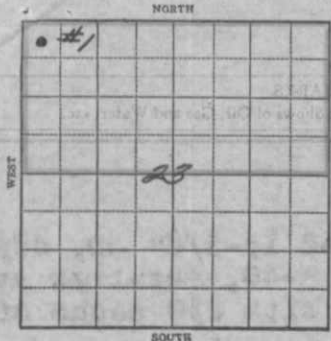

WELL RECORD

Lease Name and No. **Tom Norton #26113** Well No. **1** Elev. **2507' DF**
 Lease Description **North Half (N/2) of Section 23, Township 17 South, Range 26 West, Ness County, Kansas**
 Location made **April 5** 19 **44** by **Could Randolph**
330 feet from North line **330** feet from East line } of **N/2**
330 feet from South line **330** feet from West line } of **Sec. 23**

Work com'd. **May 2** 19 **44** Rig comp'd. **May 6** 19 **44** Drlg. com'd. **May 10** 19 **44** Drlg. comp'd. **June 5** 19 **44**
 Rig Contractor **Helmerich and Payne Drilling Company**
 Drilling Contractor **Helmerich and Payne Drilling Company, Tulsa, Oklahoma**
 Rotary Drilling from **Top** to **4461'** Cable Tool Drilling from _____ to _____

Commenced Producing **August 24** 19 **44** Initial Prod. before shot or acid **3/4 bbl. oil per hr.** Bbls.
 Initial Prod. after shot or acid **10B 8 hrs., 45.20 bbls. oil** Bbls.
 Dry Gas Well Press. **no wtr., to estab. 24 hr. S.C.O. potential** Volume **of 130' bbls.** Cu. ft.
 Casing Head Gas Pressure _____ Volume _____ Cu. ft.
 Braden Head **(13-3/8" x 8-5/8")** Gas Pressure _____ Volume _____ Cu. ft.
 Braden Head **(8-5/8" x 5 1/2")** Gas Pressure _____ Volume _____ Cu. ft.

PRODUCING FORMATION **Mississippi Line** 4450' Top Bottom 4461' TOTAL DEPTH 4461'

CASING RECORD

Size	Wt.	Thds.	Where Set	PULLED OUT			LEFT IN			KIND	Cond'n	Sacks Used	CEMENTING Method Employed
				Jts.	Feet	In	Jts.	Feet	In				
13-3/8" CD48	8R		240'				12	237	0	Seamless	A	250	Halliburton
13-3/8" Casing: Range 1, Grade H-40 - Set 8' in Cellar													
8-5/8" CD28	8R		1255'				60	1265'	5	Seamless	A	750	Halliburton
8-5/8" Casing: Range 1, Grade H-40 - Set 6' in Cellar													
5-1/2" CD17	8R		4450'				140	4485'	0	Seamless	A	175	Halliburton
5-1/2" Casing: Range 2, Grade J-55 - Cased to derrick floor													
(Used 1 - 5 1/2" Combination Guide and float shoe)													

Liner Set at _____ Length _____ Perforated at _____
 Liner Set at _____ Length _____ Perforated at _____
 Packer Set at _____ Size and Kind _____
 Packer Set at _____ Size and Kind _____

SHOT OR ACID TREATMENT RECORD

Date	FIRST		SECOND		THIRD		FOURTH	
	Date	Acid Used	Date	Acid Used	Date	Acid Used		
June 17, 1944	750 Gals. Size Shot	4450 Ft. and 4461 Ft.	June 22, 1944	1500 Gals. Size Shot	4450 Ft. and 4461 Ft.	June 28, 1944	2500 Gals. Size Shot	4450 Ft. and 4461 Ft.
	Shot Between							
	Size of Shell							
	Put in by (Co.)	Dowell, Inc.	Dowell, Inc.	Dowell, Inc.				
	Length anchor							
	Distance below Cas'g							
	Damage to Casing or Casing Shoulder	None	None	None				

SIGNIFICANT GEOLOGICAL FORMATIONS

NAME	Top	Bottom	GAS		OIL		REMARKS
			From	To	From	To	
Lansing Line	3884						
Sand-Chert							
Conglomerate	4433	BLM					
Mississippi Line	4449				4449	4457	Porous, oil saturated
					4457	4461	Porous, sli. saturation
							PAY FORMATION

CLEANING OUT RECORDS

	DATE COMMENCED	DATE COMPLETED	PROD. BEFORE	PROD. AFTER	REMARKS
1st					See Reverse for other details.
2nd					" " " " "
3rd					" " " " "
4th					" " " " "

PLUGGING BACK AND DEEPENING RECORDS

	Date Commenced	Date Completed	No. Feet Plugged Back or Deepened	Prod. Before	Prod. After	REMARKS
1st						See Reverse for other details.
2nd						" " " " "
3rd						" " " " "
4th						" " " " "

PLUGGING
 FILE SEC 23 T 17 R 26W
 BOOK PAGE 112 LINE 16

(See Reverse for Record of Formation)

RECORD OF FORMATIONS

FORMATION	TOP	BOTTOM	REMARKS
Surface soil and clay	0	30	
Sand	30	40	
Shale	40	255	Set and cemented 13-3/8" OD, 48#, Range 1, Grade H-40, seamless steel casing at 240' with 250 sacks of cement.
Shale	255	625	
Sand and shale	625	700	
Sand	700	725	
Lime and shale	725	890	
Sandy shale	890	925	
Shale and lime	925	990	
Sand	990	1005	
Shale	1005	1130	
Shale and sand	1130	1220	
Anhydrite	1220	1255	Set and cemented 8-5/8" OD, 28#, 8 round thread, Range 1, Grade H-40, seamless steel casing at 1255' with 500 sacks of cement. Cement did not circulate, ran 1" pipe between 13-3/8" and 8-5/8" casing and cemented top of 8-5/8" casing with 230 sacks of cement.
White anhydrite	1255	1265	
Red shale	1265	1465	
Red sand	1465	1480	
Red shale	1480	1700	
Shale and lime shells	1700	1830	
Shale	1830	1878	
Shale and lime	1878	1930	
Shale	1930	2065	
Shale and lime	2065	2250	
Shale and salt	2250	2350	
Shale and lime	2350	2550	
Broken lime	2550	2595	
Lime and shale	2595	2630	
Brown lime with red shale	2630	2675	
Broken lime	2675	2750	
Lime	2750	2890	
Lime and shale	2890	2900	
Lime	2900	2935	
Lime and shale	2935	3085	
Lime	3085	3150	
Lime and shale	3150	3690	
Shale and shells	3690	3765	
Shale and lime	3765	3840	
Lime	3840	3920	
Broken lime	3920	3949	
Lime	3949	3972	
Cherty lime	3972	4004	
Lime	4004	4133	
Shale and lime	4133	4163	
Lime	4163	4235	
Shale and lime	4235	4350	
Shale	4350	4360	
Shale and lime	4360	4405	
Grey lime and shale	4405	4442	
Grey sand and chert	4442	4454	
Grey sand and shale	4454	4458	
Medium soft brown dolomite	4458	4466	
Soft finely crystalline grey & brown dolomite	4466	4470	
			TOP BAND - CHERT CONGLOMERATE 4433' SLM
			TOP MISSISSIPPI LINE 4449' SLM
			TOP LAUREL LINE 3884'
			Porous, slight saturation Ran Halliburton drill stem test with packer set at 4448' SLM, open 25 minutes, recovered 25' of 34 degree gravity oil, no water and 25' of oily drilling mud. Laid down drill pipe and set and cemented 5 1/2" OD, 8 round thread, Grade J-55, Range 2, 17#, J & L, Seamless steel casing at 4450' SLM with 175 sacks of cement. Finished cementing at 9:45 AM June 7, 1944, and while shut down waiting on cement to set, moved in and rigged up cable tools. Finished rigging up cable tools and bailed the hole down on June 14th and 5 1/2" casing tested OK. Drilled cement plug and cement job tested OK. Correction: 4470' SLM rotary table equals 4461' SLM derrick floor. Tested 3/4 barrels oil per hour
SLM	4470	4461	
TOTAL DEPTH		4461'	

washed formation with acid for 12 hours, then bailed and tested 1 1/2 barrels oil per hour. On June 16th ran 2" tubing and on June 17th treated with 750 gallons of acid as follows:

ACID TREATMENT NO. 1 - Between 4450' and 4461'

Treatment put in June 17, 1944, by Dowell, Inc., using 750 gallons acid, 120 barrels of water to fill hole and to flush:

TIME	CP	TP	REMARKS
1:37 PM			Hole filled with 102 barrels water and started acid in
1:52 PM	300#	1000#	750 gallons acid in hole on bottom
3:00 PM	1200#	1050#	6 barrels flushing water in hole
4:00 PM	1200#	1100#	10 barrels flushing water in hole
5:25 PM	1300#	1300#	18 barrels flushing water in hole and treatment complete

After acid treatment, swabbed through 2" tubing 20 hours, estimated 105 barrels oil, then swabbed into test tank 5 hours, 19 barrels oil, swabbing 250' off bottom.

On June 19th swabbed 8 hours, 15 barrels oil, swabbing to 250' off bottom, then ran rods and on June 20th POB 24 hours, 5 barrels oil and no water. On June 21st POB 24 hours, 30.19 barrels oil and no water.

On June 22nd pulled rods and reacidized with 1500 gallons of Dowell "XX-F-16" acid as follows:

ACID TREATMENT NO. 2 - Between 4450' and 4461'

Treatment put in June 22, 1944, by Dowell, Inc., using 1500 gallons acid and 130 1/2 barrels oil to fill hole and to flush:

TIME	CP	TP	REMARKS
4:29 PM			Hole filled with 112 barrels oil and started acid in
4:40 PM	150#		500 gallons "XX-F-16" acid in
5:10 PM			500 gallons "X-F-16" acid in
6:03 PM	1125#	525#	1000 gallons "X-F-16" acid in and started oil flush
7:11 PM	1050#	775#	12 barrels flushing oil in hole
7:50 PM	950#	750#	17 barrels flushing oil in hole
8:20 PM	700#	700#	18 1/2 barrels flushing oil in hole and treatment complete

After acid treatment, swabbed through 2" tubing 13 hours, 63 barrels of oil and no water, then ran rods and POB 10 hours, 52 barrels of oil and no water.

On June 24th POB 24 hours, 84 barrels oil and no water. June 25th pulled 2" tubing and rods, and on June 26th swabbed through 5 1/2" casing 7 hours, 17 barrels oil, swabbing to bottom, and while swabbing lost bottom swab connection in hole.

Recovered bottom swab connection on June 27th and swabbed through 5 1/2" casing 18 hours, 24 barrels oil, swabbing to bottom. June 28th ran 2" tubing and treated with 2500 gallons of Dowell "XX-F-16" acid as follows:

ACID TREATMENT NO. 3 - Between 4450' and 4461'

Treatment put in June 28th, 1944, by Dowell, Inc., using 2500 gallons acid and 141 barrels oil to fill hole and to flush:

TIME	CP	TP	REMARKS
5:05 PM			Hole filled with 124 barrels oil and started acid in
5:26 PM	450#		700 gallons acid in hole
5:48 PM	1300#	850#	1500 gallons acid in hole
6:20 PM	1500#	1050#	2000 gallons acid in hole
6:30 PM	1450#	1000#	2500 gallons acid in hole and started oil flush
6:49 PM	1000#	1000#	Hole flushed with 17 barrels oil and treatment complete

After acid treatment, swabbed through 2" tubing 10 hours, 54 barrels oil (oil used in treatment), and on June 29th swabbed 5 hours, 28 barrels oil. Ran tubing and rods and on June 30th POB 24 hours, 84 barrels oil and no water. Established minimum well allowable based on this pumping test.

Installed regular pumping equipment and on August 24th POB 8 hours for State Corporation Commission potential test, 43.20 barrels oil and no water, to establish 24 hour State Corporation Commission potential of 130 barrels. This potential allows 25 barrels per day.

SLOPE TEST DATA

DEPTH	ANGLE OF DEFLECTION	DEPTH	ANGLE OF DEFLECTION
250'	0 Degrees	2250'	0 Degrees
500'	0 "	2500'	0 "
750'	0 "	2750'	0 "
1000'	0 "	3000'	0 "
1250'	0 "	3250'	0 "
1500'	0 "	3500'	0 "
1750'	0 "	3750'	0 "
2000'	0 "	4000'	0 "
		4250'	0 "

PLUGGING
FILE SEC 23 T 17 R 26
PAGE 112 LINE 16

