

15-135-22424-0000


STATE OF KANSAS
STATE CORPORATION COMMISSION
200 Colorado Derby Bldg.
Wichita, Kansas 67202

Form CP-4
Rev. 12-15-80

WELL PLUGGING RECORD

Give All Information Completely
Make Required Affidavit

COUNTY Ness SEC. 25 TWP. 17S RGE. 26W xR/W
Location as in quarters or footage from lines:
NE SW SW

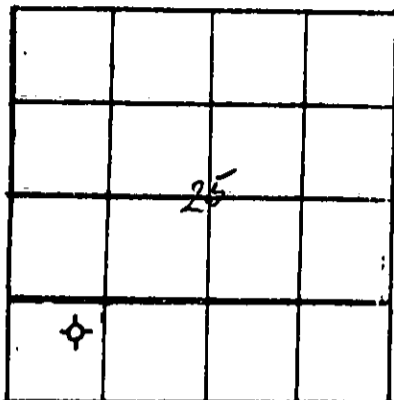

Locate Well
correctly on above
Section Platt.

Lease Owner Viking Resources
Lease Name Norton Well No. #1
Office Address 217 E. William Street Wichita, Ks. 67202
Character of Well (Completed as Oil, Gas or Dry Hole): D.H.
Date Well Completed 8-16-83
Application for plugging filed 8-16-83
Plugging commenced 8-16-83
Plugging completed 8-16-83
Reason for abandonment of well or producing formation _____

Was permission obtained from the Conservation Division or it's
Agent's before plugging was commenced? yes

Name of Conservation Agent who supervised plugging of this well Steve Durrant

Producing formation _____ Depth to top _____ bottom T.D. 4395'

Show depth and thickness of all water, oil and gas formations.

OIL, GAS OR WATER RECORDS

Casing Record

Formation	Content	From	To	Size	Put in	Pulled Out
Surface	7 jts. 24#	8 5/8"	272'	set @ 275'	g.l. cem.	w/150 sx.
	60-40 pos mix, 3%		c.c. 2%	gel		

Describe in detail the manner in which the well was plugged, indicating where the mud
fluid was placed and the method or methods used in introducing it into the hold. If cement
or other plugs were used, state the character of same and depth placed, from _____ feet
to _____ feet for each plug set.

T.D. 4395' Plugged @ 2:25 p.m. 1st plug @ 1740' w/50 sx., 2nd plug @ 870' w/50 sx., 3rd plug @ 300' w/40 sx., solid bridge plug 0-40' w/10 sx. cement, 1 sx. hulls, 10 sx. in the rat hole, 160 sx., total 60-40 pos mix, 2% gel, 3% c.c., Steve Durrant State Plugger, Completed 4:00 p.m.

RECEIVED
STATE CORPORATION COMMISSION

AUG 22 1983

RECEIVED
STATE CORP COMMISSION

CONSERVATION DIVISION
Wichita, Kansas

AUG 22 1983

(If additional description is necessary, use BACK of this sheet)

Name of Plugging Contractor Warrior Drilling Co.

CONSERVATION DIVISION
Wichita, Kansas

STATE OF Kansas COUNTY OF Sedgwick, ss.


V. Richard Hoover (owner or operator) of the
above-described well, being first duly sworn on oath, says: That I have knowledge of the
facts, statements, and matters herein contained and the log of the above-described well as
filed and that the same are true and correct. So help me God.

(Signature) V. Richard Hoover
V. Richard Hoover
(Address)

905 Century Plaza Wichita, Ks. 67202

SUBSCRIBED AND SWORN TO before me this

16th day of August, 19 83

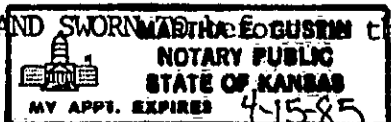

Martha E. Gustin
Martha E. Gustin Notary Public.

My Commission expires: _____

15-135-22424-0000

DRILLERS LOG

August 16, 1983

NORTON #1
NE SW SW Sec. 25-17S-26W
Ness County, Kansas

OPERATOR: Viking Resources
CONTRACTOR: Warrior Drilling Company
COMMENCED: 8-08-83 Moving in
8-09-83 Spudded in
COMPLETED: 8-16-83

0	283	Surface Sand	ELEVATIONS:
283	752	Surface Sand & Clay	2415 Gr.
752	1748	Surface Shale	2417 D.F.
1748	1778	Anhydrite	2420 K.B.
1778	2477	Shale	
2477	3045	Shale & Lime	
3045	3390	Lime & Shale	
3390	3960	Shale	
3960	4080	Lime & Shale	
4080	4395	Lime	
4395		RTD	

D & A

We certify that the above and foregoing is a true and correct copy of the log on the #1 NORTON, located in Ness County, Kansas

RECEIVED
STATE CORPORATION COMMISSION

WARRIOR DRILLING, COMPANY

AUG 22 1983

CONSERVATION DIVISION
Wichita, Kansas

V. Richard Hoover
V. Richard Hoover, President

Subscribed and sworn to before me this 16th day of August, 1983.

MARTHA E. GUSTIN
NOTARY PUBLIC
STATE OF KANSAS
EXPIRES

Martha E. Gustin
Martha E. Gustin, Notary Public