


STATE OF KANSAS  
STATE CORPORATION COMMISSION

WELL PLUGGING RECORD

Give All Information Completely  
Make Required Affidavit  
Mail or Deliver Report to  
Conservation Division  
State Corporation Comm.  
245 North Water  
Wichita, KS 67202

Ness County, Sec. 28 Twp. 17S Rge. 26 E/W  
Location as "NE/CNW $\frac{1}{4}$ SW $\frac{1}{4}$ " or footage from lines  
SE NE SE

Lease Owner Euwer Petroleum Co.  
Lease Name Solze Well No. 1  
Office Address 110 N. Market - Suite 206, Wichita, Kansas  
Character of Well (Completed as Oil, Gas or Dry Hole) 67202  
Dry Hole

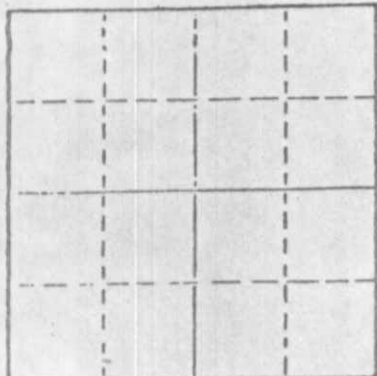

Locate well correctly on above  
Section Plot

Date Well completed 6-17-78 19  
Application for plugging filed 6-17-78 19  
Application for plugging approved 6-17-78 19  
Plugging commenced 6-17-78 19  
Plugging completed 6-17-78 19  
Reason for abandonment of well or producing formation  
Commercial quantities of oil not found.  
If a producing well is abandoned, date of last production 19

Was permission obtained from the Conservation Division or  
its agents before plugging was commenced? yes

Name of Conservation Agent who supervised plugging of this well Leo Massey, Hays, Kansas  
Producing formation \_\_\_\_\_ Depth to top \_\_\_\_\_ Bottom \_\_\_\_\_ Total Depth of Well 4432'  
Show depth and thickness of all water, oil and gas formations.

OIL, GAS OR WATER RECORDS

CASING RECORD

FORMATION	CONTENT	FROM	TO	SIZE	PUT IN	PULLED OUT
				8-5/8"	287'	

Describe in detail the manner in which the well was plugged, indicating where the mud fluid  
was placed and the method or methods used in introducing it into the hold. If cement or other  
plugs were used, state the character of same and depth placed, from \_\_\_\_\_ feet to  
\_\_\_\_\_ feet for each plug set.

Plugged @ 720' with 70 sx.  
240' with 20 sx.  
40' with 10 sx.

RECEIVED  
STATE CORPORATION COMMISSION  
JUL 03 1978

CONSERVATION DIVISION  
Wichita, Kansas

(If additional description is necessary, use BACK of this sheet)

Name of Plugging Contractor Buffalo Drilling Company, Inc.

STATE OF KANSAS COUNTY OF SEDGWICK, ss.  
Wilson Rains (employee of owner) or (owner or operator)  
of the above-described well, being first duly sworn on oath, says: That I have knowledge of  
the facts, statements, and matters herein contained and the log of the above-described well  
as filed and that the same are true and correct. So help me God.

(Signature) Wilson Rains Wilson Rains  
435 Page Ct., 220 W. Douglas, Wichita, Kansas  
(Address) 67202

SUBSCRIBED AND SWORN TO before me this 19th day of June, 1978



My commission expires October 4, 1979  
Juanita M. Green Notary Public.

DRILLER'S LOG

COMPANY: Euwer Petroleum Co. SEC. 28 T. 17S R. 26W  
 WELL NAME: Solze #1 LOC. SE NE SE  
 RIG NO. 7 COUNTY: Ness County, Kansas  
 TOTAL DEPTH 4432' ELEVATION  
 COMMENCED: 6-9-78 COMPLETED: 6-17-78  
 CONTRACTOR: Buffalo Drilling Company, Inc.  
 CASING RECORD:  
 SURFACE: 8-5/8" set @ 287' with 225 sx. 60/40 poz., 2% gel, 3% cc.  
 PRODUCTION: D & A

LOG  
 (Figures Indicate Bottom of Formations)

Shale and Sand	287
Shale	485
Shale and Sand	1290
Sand	1547
Shale	1795
Anhydrite	1824
Shale	2007
Shale and Lime	2570
Shale	2739
Shale with Lime streaks	2940
Shale and Lime	3131
Lime and Shale	3770
Lime and Sandy Shale	3920
Lime and Red Shale	4045
Lime	4211
Lime and Shale	4300
Lime	4395
Lime and Mississippi	4402
Mississippi	4424
Shale and Lime	4432
<u>Rotary Total Depth</u>	<u>4432</u>

RECEIVED  
 STATE CORPORATION COMMISSION

JUL 03 1978

CONSERVATION DIVISION  
 Wichita, Kansas.

STATE OF KANSAS)  
 COUNTY OF SEDGWICK)

SS:

I, Wilson Rains of Buffalo Drilling Company, Inc.  
 upon oath state that the above and foregoing is a true and correct copy of the log of the  
Solze #1 well.

Wilson Rains  
 WILSON RAINS

Subscribed and sworn to before me this 19th day of June, 1978.

My Appointment Expires:  
October 4, 1979

Juanita M. Green  
 Juanita M. Green - Notary Public

