


Give All Information Completely
Make Required Affidavit
Mail or Deliver Report to:
Conservation Division
State Corporation Commission
211 No. Broadway
Wichita, Kansas

WELL PLUGGING RECORD

NORTH

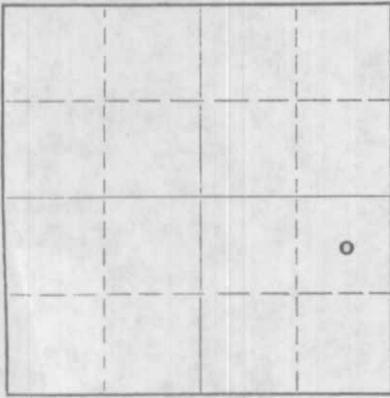

Locate well correctly on above
Section Plat

Ness County, Sec. 29 Twp. 17S Rge. 26W (E) (W)

Location as "NE/CNWxSWx" or footage from lines c NE SE
Lease Owner Kern-Landes Exploration Co. Inc.
Lease Name Wilkerson Well No. 1
Office Address P. O. Box 699, Magnolia, Arkansas
Character of Well (completed as Oil, Gas or Dry Hole) Dry Hole
Date well completed November 22 19 62
Application for plugging filed November 22 19 62
Application for plugging approved November 22 19 62
Plugging commenced November 22 19 62
Plugging completed November 22 19 62
Reason for abandonment of well or producing formation Dry Hole

If a producing well is abandoned, date of last production _____ 19____
Was permission obtained from the Conservation Division or its agents before plugging was commenced? Yes

Name of Conservation Agent who supervised plugging of this well Eldon Petty, Box 326, Hays, Kansas
Producing formation _____ Depth to top _____ Bottom _____ Total Depth of Well 4510 Feet
Show depth and thickness of all water, oil and gas formations.

OIL, GAS OR WATER RECORDS

CASING RECORD

FORMATION	CONTENT	FROM	TO	SIZE	PUT IN	PULLED OUT
		0	287'	8 5/8"	287'	None

Describe in detail the manner in which the well was plugged, indicating where the mud fluid was placed and the method or methods used in introducing it into the hole. If cement or other plugs were used, state the character of same and depth placed, from _____ feet to _____ feet for each plug set.

Set Plug @ 270' 25 sacks cement & 1/4 sack Hulls
Plug & 30' 10 sacks cement & 1/4 sacks Hulls

RECEIVED
STATE CORPORATION COMMISSION

DEC 12 1962

CONSERVATION DIVISION
Wichita, Kansas

(If additional description is necessary, use BACK of this sheet)

Name of Plugging Contractor Hellar Drilling Company, Inc.
Address 1014 Union Center, Wichita 2, Kansas

STATE OF Kansas, COUNTY OF Sodgwick, ss.

D. L. Hellar, Pres. of Hellar Drlg. Co. Inc. (employee of owner) or (owner or operator) of the above-described well, being first duly sworn on oath, says: That I have knowledge of the facts, statements, and matters herein contained and the log of the above-described well as filed and that the same are true and correct. So help me God.

(Signature) D. L. Hellar
D. L. Hellar - President
1014 Union Center, Wichita 2, Kansas
(Address)

SUBSCRIBED AND SWORN TO before me this 11th day of December, 19 62

My commission expires March 25, 1964.

Catherine Darcey
Catherine Darcey - Notary Public.



15-135-00547-0000

DRILLER'S LOG

OWNER:	Kern-Landes Exploration Co. Inc.
CONTRACTOR:	Hellar Drilling Company, Inc.
LEASE:	#1 Wilkerson
LOCATION:	c NE SE Section 29-17S-26W Ness County, Kansas
COMMENCED:	November 6, 1962
COMPLETED:	November 22, 1962
CASING:	Set 8 5/8" surface casing @ 287' /215 sacks cement

0- 287	Sand, shale & red Bed
287- 330	Shale
330-1862	Shale, Red Bed, sand
1862-1892	Red Bed
1892-1926	Cimm. Anhydrite
1926-2122	Shale
2122-2384	Shale, Red Bed
2384-2581	Shale, Red Bed, salt
2581-3870	Lime & Shale
3870-3962	Lime (Kansas City)
3962-4045	Lansing- K. C.
4045-4089	Lime
4089-4132	Lansing- K. C.
4132-4291	Lime
4291-4356	Lime & Shale
4356-4379	Core #1
4379-4384	Core #2
4384-4386	Lime
4386-4434	Lime, shale & chert
4434-4447	Lime & shale
4447-4464	Core #3
4464-4478	Core #4
4478-4490	Lime & Shale
4490-4510	Mississippi
4510	Rotary Total Depth D & A

RECEIVED
STATE CORPORATION COMMISSION

DEC 12 1962

CONSERVATION DIVISION
Wichita, Kansas

Fidelity Oil & Gas Skin

STATE OF KANSAS)
) SS
 COUNTY OF SEDGWICK)

I, D. L. Hellar, do hereby certify that the above and foregoing is a true and Correct copy of the log of the #1 Wilkerson, located in the c NE SE of Section 27-17S-26W, Ness County, Kansas, as reflected by the files of the Hellar Drilling Co., Inc.

HELLAR DRILLING COMPANY, INC.

By *D. L. Hellar*
 D. L. Hellar, President

Subscribed and sworn to before me, a Notary Public, in and for Sedgwick County, Kansas, this 11th day of December, 1962.

Catherine Darcey
 Notary Public - Catherine Darcey

My Commission Expires:
March 25, 1964.