

WELL PLUGGING RECORD


Give All Information Completely
Make Required Affidavit
Mail or Deliver Report to:
Conservation Division
State Corporation Commission
212 No. Market
Wichita, Kansas

Ness

ANBec 23
County, Sec 28

Twp. 18S Rge. (E) 24 (W)

Location as "NE/CNW/SW" or footage from lines C NE NE
Lease Owner Tilco et al
Lease Name Debes "A" Well No. 1
Office Address P.O. Box 486 Great Bend, Kansas
Character of Well (completed as Oil, Gas or Dry Hole) dry hole
Date well completed December 30 19 69
Application for plugging filed December 30 19 69
Application for plugging approved December 30 19 69
Plugging commenced December 30 19 69
Plugging completed December 30 19 69
Reason for abandonment of well or producing formation dry hole

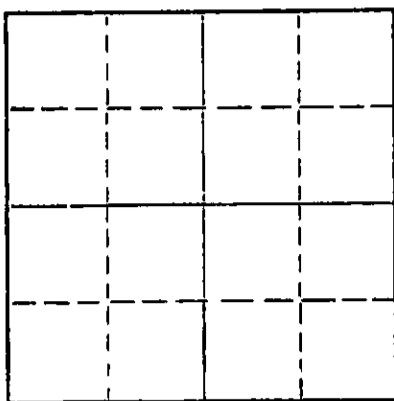

Locate well correctly on above Section Plat

If a producing well is abandoned, date of last production 19
Was permission obtained from the Conservation Division or its agents before plugging was commenced? yes

Name of Conservation Agent who supervised plugging of this well Leo Massey
Producing formation Depth to top Bottom Total Depth of Well 4345 Feet
Show depth and thickness of all water, oil and gas formations.

OIL, GAS OR WATER RECORDS

CASING RECORD

FORMATION	CONTENT	FROM	TO	SIZE	PUT IN	PULLED OUT
				8 5/8"	310'	None

Describe in detail the manner in which the well was plugged, indicating where the mud fluid was placed and the method or methods used in introducing it into the hole. If cement or other plugs were used, state the character of same and depth placed, from feet to feet for each plug set.

Plug hole @ 660' w/70 sxs. Plug @ 300' w/20 sxs. Plug @ 40' w/10 sxs. 50/50 Pozmix and 10% Gel.

RECEIVED
STATE CORPORATION COMMISSION

FEB 6 1970

CONSERVATION DIVISION
Wichita, Kansas

(If additional description is necessary, use BACK of this sheet)
Name of Plugging Contractor Leben Drilling, Inc.
Address P.O. Box 486 Great Bend, Kansas

STATE OF Kansas, COUNTY OF Barton, ss.


James R. Rodgers (employee of owner) or (owner or operator) of the above-described

well, being first duly sworn on oath, says: That I have knowledge of the facts, statements, and matters herein contained and the log of the above described well as filed and that the same are true and correct. So help me God.

(Signature) James R. Rodgers

P.O. Box 486 Great Bend, Kansas
(Address)

Sworn to before me this 3rd day of February, 19 70

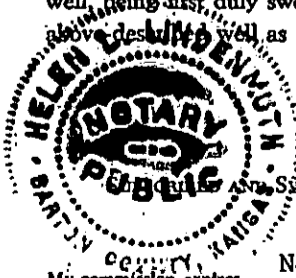

Helen L. Lindenmuth
Notary Public.

November 13, 1973

My commission expires

DRILLER'S LOG

COMPANY	TILCO, ET AL
CONTRACTOR	LEBEN DRILLING, INC.
FARM	DEBES A #1
LOCATION	C NE NE SECTION 28-18S-24W NESS COUNTY 22
COMMENCED	12-20-69
COMPLETED	12-30-69 A.UBKE

0	102	Surface Soil, Sand
102	312	Shale, Sand
312	340	Shale
340	618	Shale, Shells
618	621	Hard Sand, Pyrite
621	934	Shale, Red Bed
934	949	Blaine
949	1050	Red Bed
1050	1265	Sand
1265	1395	Shale
1395	1571	Red Bed
1571	1607	Anhydrite
1607	2172	Shale, Shells
2172	2985	Lime, Shale
2985	3220	Lime
3220	3455	Shale, Lime
3455	3740	Lime, Shale
3740	3825	Lime
3825	3915	Lime, Shale
3915	4317	Lime
4317	4345	Mississippian
	<u>4345</u>	<u>RTD D & A</u>

8 5/8" 20# new surface casing set @ 310' cemented with 200 sacks cement, 2% gel, 2% cc

I, James Rodgers, do hereby certify that the above and foregoing is a true and correct copy of the log of the Debes A #1 Well, located C NE NE of Section 22, Township 18 South, Range 24 West, Ness County, Kansas, as reflected by the records of Leben Drilling, Inc.

James Rodgers
James Rodgers

STATE OF KANSAS)
) ss
COUNTY OF BARTON)

Subscribed and sworn to and before me a Notary Public, in and for
County, Kansas, this 2nd day of February, 1970.



Helen L. Lindenmuth
Helen L. Lindenmuth

My Commission Expires:
November 13, 1973

RECEIVED
STATE CORPORATION COMMISSION
FEB 6 1970
CONSERVATION DIVISION
Wichita, Kansas