

CARD MUST BE TYPED

State of Kansas
NOTICE OF INTENTION TO DRILL

CARD MUST BE SIGNED

(see rules on reverse side)

March 2, 1985

Starting Date:

month day year 5181 1:45

OPERATOR: License #

Name Donald C. Slawson

Address 200 Douglas Building

City/State/Zip Wichita, Kansas 67202

Contact Person Bill Horigan

Phone 263-3201

CONTRACTOR: License # 5657

Name Slawson Drilling Co., Inc.

City/State Wichita, Kansas 67202

Well Drilled For: Well Class: Type Equipment:

Oil Swd Infield Mud Rotary

Gas Inj Pool Ext. Air Rotary

OWWO Expl Wildcat Cable

If OWWO: old well info as follows:

Operator

Well Name

Comp Date Old Total Depth

Projected Total Depth 4600' feet

Projected Formation at TD Miss

Expected Producing Formations Lsg/KC

API Number 15- 101-21,140-00-00

NE NW Sec 10, Twp 16S, S, Rge 27W East West
(location)

4620' Ft North from Southeast Corner of Section

3300' Ft West from Southeast Corner of Section

(Note: Locate well on Section Plat on reverse side)

Nearest lease or unit boundary line 650 feet

County Lane

Lease Name Mendenhall "AA" Well# J

Domestic well within 330 feet: yes no

Municipal well within one mile: yes no

Depth to Bottom of fresh water 740 feet

Lowest usable water formation Dakota

Depth to Bottom of usable water 1000 feet

*Surface pipe by Alternate: 1 2

*Surface pipe to be set 760 feet

*Conductor pipe if any required feet

Ground surface elevation 2603' feet MSL

This Authorization Expires 7-1-85

Approved By 3-1-85 [Signature]

I certify that we will comply with K.S.A. 55-101, et seq., plus eventually plugging hole to K.C.C. specifications.

Date 3/1/85 Signature of Operator or Agent

[Signature] Title
Eldon S. West III

Div. Mgr. / Geologist

Form C-1 4/84


MHC/WOHE 3-1-85

RECEIVED
STATE CORPORATION COMMISSION

Must be filed with the K.C.C. five (5) days prior to commencing well
This card void if drilling not started within six (6) months of date received by K.C.C.

MAR 1 1985

CONSERVATION DIVISION
Wichita, Kansas
A Regular Section of Land
1 Mile = 5,280 Ft.

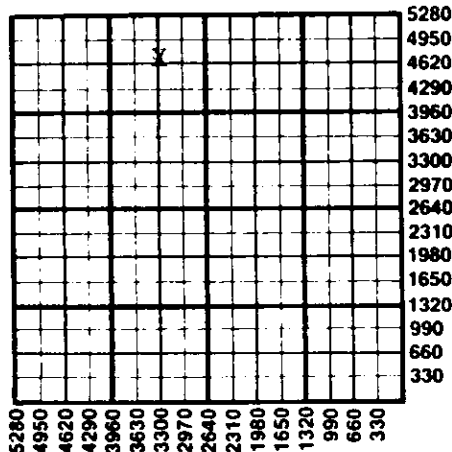

Important procedures to follow :

1. Notify District office before setting surface casing.
2. Set surface casing by circulating cement to the top.
3. File completion forms ACO-1 with K.C.C. within 90 days of well completion, following instructions on ACO-1, side 1, and including copies of wireline logs.
4. Notify District office 48 hours prior to old well workover or re-entry.
5. Prior to plugging, prepare a plugging plan, then obtain agreement from the appropriate district office for an approved plugging plan.
6. Submit plugging report (CP-4) to K.C.C. after plugging is completed.
7. Obtain an approved injection docket number before disposing of salt water.
8. Notify K.C.C. within 10 days when injection commences or terminates.
- * 9. If an alternate 2 completion, cement in the production pipe from below any usable water to surface within 120 days of spud date.

* Circulate alternative cementing material per
82-3-106(b)4.

State Corporation Commission of Kansas
Conservation Division
200 Colorado Derby Building
Wichita, Kansas 67202
(316) 263-3238