

# NOTICE OF INTENTION TO DRILL

(see rules on reverse side)

Starting Date ..... April 6, 1986 .....  
month day year

API Number 15— 135-01,005-00-02

OPERATOR: License # ..... 5399 .....  
Name American Energies Corporation .....  
Address 575 Fourth Financial Center .....  
City/State/Zip Wichita, KS 67202 .....  
Contact Person Alan DeGood .....  
Phone 316-263-5785 .....

..... East  
C SW NW Sec. 28 Twp. 17 S, Rg. 22 XX West  
3300 ..... Ft. from South Line of Section  
4620 ..... Ft. from East Line of Section

(Note: Locate well on Section Plat on reverse side)

CONTRACTOR: License # ..... 5131 .....  
Name Thunderbird Drilling, Inc. .....  
City/State Wichita, KS 67218 .....

Nearest lease or unit boundary line ..... 660 ..... feet  
County Ness .....

Well Drilled For: Well Class: Type Equipment:  
 Oil  XSWD  Infield  Mud Rotary  
 Gas  Inj  Pool Ext.  Air Rotary  
 OWWO  Expl  Wildcat  Cable

Lease Name Pavlu ..... Well # #1 SWD .....  
Ground surface elevation ..... 2258 ..... feet MSL

IF OWWO: old well info as follows: Mull Delg.  
Operator Kansas Crude, Inc. .....  
Well Name Pavlu #1 ..... } re-entered in 76  
Comp Date 9/4/76 1-20-83 ..... Old Total Depth 4340' .....

Domestic well within 330 feet:  yes  no  
Municipal well within one mile:  yes  no  
Surface pipe by Alternate:  1  2  9  
Depth to bottom of fresh water ..... 250' .....  
Depth to bottom of usable water ~~600'~~ 820 .....  
Surface pipe ~~planned to be~~ set ..... 263' .....  
Projected Total Depth ..... 1550' ..... feet  
Formation Cedar Hills .....

I certify that well will comply with K.S.A. 55-101, et seq., plus eventually plugging hole to KCC specifications.

..... cementing will be done immediately upon setting production casing.

Date 4/7/86 ..... Signature of Operator or Agent Alan D. Good ..... Title Vice President ..... RCH/KCH

For KCC Use:

Conductor Pipe Required ..... feet; Minimum Surface Pipe Required ..... 200 ..... feet per AN 4 2


This Authorization Expires 10-3-86 ..... Approved By 4-2-86 RC .....

Must be filed with the K.C.C. five (5) days prior to commencing well  
This card void if drilling not started within six (6) months of date received by K.C.C.

### Important procedures to follow:

1. Notify District office before setting surface casing.
2. Set surface casing by circulating cement to the top.
3. File completion forms ACO-1 with K.C.C. within 90 days of well completion, following instructions on ACO-1, side 1, and including copies of wireline logs.
4. Notify District office 48 hours prior to old well workover or re-entry.
5. Prior to filing Intent, prepare a proposed plugging plan in case well is D & A, then obtain approval of plan when calling district office prior to setting surface pipe.
6. Submit plugging report (CP-4) to K.C.C. after plugging is completed.
7. Obtain an approved injection docket number before disposing of salt water.
8. Notify K.C.C. within 10 days when injection commences or terminates.
9. If an alternate 2 completion, cement in the production pipe from below any usable water to surface within 120 days of spud date.

### A Regular Section of Land 1 Mile = 5,280 Ft.

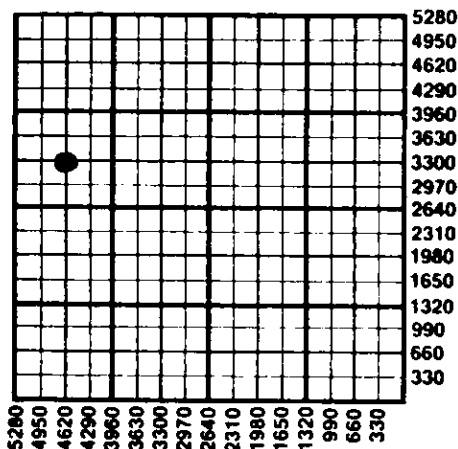

STATE CORPORATION COMMISSION

APR - 2 1985

CONSERVATION DIVISION  
Wichita, Kansas

State Corporation Commission of Kansas  
Conservation Division  
200 Colorado Derby Building  
Wichita, Kansas 67202  
(316) 263-3238



JOHN GARLIN  
MICHAEL LENNEN  
MARGALEE WRIGHT  
KEITH R. HENLEY  
JUDITH A. McCONNELL  
BRIAN J. MOLINE

Governor  
Chairman  
Commissioner  
Executive Secretary  
General Counsel

State Corporation Commission

CONSERVATION DIVISION

(Oil, Gas and Water)  
200 Colorado Derby Building  
202 West 1st Street  
WICHITA, KANSAS 67202-1286

November 4, 1986

American Energies Corp.  
575 Fourth Financial Center  
Wichita, KS 67202

Re: Pavlu #1 SWD, 28-17-22W, Ness County, KS

Gentlemen:

In reviewing our Intent-to-Drill File we find the approved notice of Intent-To-Drill for the above-referenced well or lease has expired per K.A.R. 82-3-103(d). The current status of this well or lease is unknown. According to K.A.R. 82-3-130, a completion report (ACO-1) must be filed within 120 days after spud date, regardless of how it is completed.

Please furnish us the following information and return it along with the required forms within fifteen (15) days of this mailing.

- Well was never drilled.  
(Complete affidavit below and return to this office.)
- Well has been abandoned.  
(Return with completed ACO-1 & CP-4 Plugging Form.)
- Well is Temporarily Abandoned.  
(Return with completed ACO-1 & CP1-11 Temporarily Abandoned Well Form.)
- Well was completed and producing.  
(Return with completed ACO-1 & Contact field office for state test.)

Should you have any questions please call (316) 263-3238.

Respectfully,

*Kathy Carlisle*  
Kathy Carlisle

AFFIDAVIT


I, Alan L. DeGood, am the duly authorized agent or representative for American Energies Corporation. I hereby state that the Pavlu #1 SWD well or lease Sec. 28, Twn. 17S, Rng. 22W in Ness County for which the Intent-to-Drill was issued to the above named entity by the Kansas Corporation Commission was never drilled.

Alan L. DeGood  
NAME & TITLE

Subscribed and sworn to before me this 10th day of November, 1986.

LuAnn Hershorn  
Notary Public LuAnn Hershorn

My Commission expires: 8-29-88

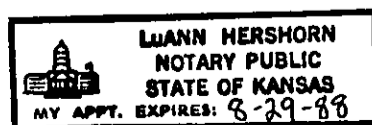

NOV 12 1986