

CARD MUST BE TYPED

State of Kansas
NOTICE OF INTENTION TO DRILL

CARD MUST BE SIGNED

(see rules on reverse side)

Starting Date: May 20 1985
month day year

API Number 15- 135-22,822-00-00

OPERATOR: License # 4174

NWSENW Sec 3 Twp 18 S, Rge 22W
(location) East West

Name Western Oil Corporation

Address P.O. Box 15265

City/State/Zip Lakewood, Colorado 80215

Contact Person Jerry Pope

Phone 303 980-9340

3630 Ft North from Southeast Corner of Section

3630 Ft West from Southeast Corner of Section

(Note: Locate well on Section Plat on reverse side)

Nearest lease or unit boundary line 990 feet.

County Ness

Lease Name Reis Well# 1

Domestic well within 330 feet: yes no

Municipal well within one mile: yes no

Depth to Bottom of fresh water 200 feet

Lowest usable water formation Dakota

Depth to Bottom of usable water 575 feet


Surface pipe by Alternate: 1 2

Surface pipe to be set 600 feet

Conductor pipe if any required none feet

Ground surface elevation 2209 feet MSL

This Authorization Expires 11-13-85

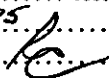Approved By 5-13-85 

* CONTRACTOR: License # 9087

Name R&C Drilling, Inc.

City/State Hays, Kansas 67601

Well Drilled For: Well Class: Type Equipment:

Oil Swd Infield Mud Rotary

Gas Inj Pool Ext. Air Rotary

OWWO Expl Wildcat Cable

If OWWO: old well info as follows:

Operator

Well Name

Comp Date Old Total Depth

Projected Total Depth 4400 feet

Projected Formation at TD Osage

Expected Producing Formations Osage

I certify that we will comply with K.S.A. 55-101, et seq., plus eventually plugging hole to K.C.C. specifications.

Date 5/10/85 Signature of Operator or Agent Jerry A. Pope

Title Petroleum Engineer


Form C-1 4/84

7M HC/NOTHE 5-13-85

Must be filed with the K.C.C. five (5) days prior to commencing well
This card void if drilling not started within six (6) months of date received by K.C.C.

Important procedures to follow :

**A Regular Section of Land
1 Mile = 5,280 Ft.**

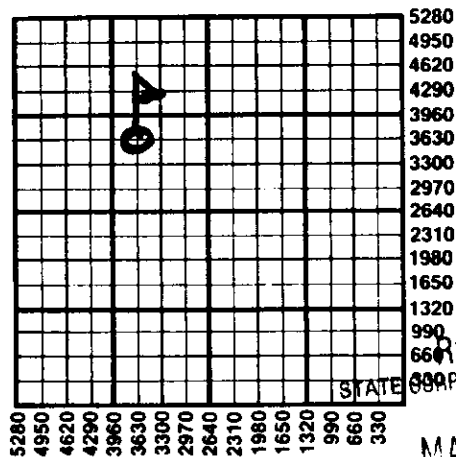

1. Notify District office before setting surface casing.
 2. Set surface casing by circulating cement to the top.
 3. File completion forms ACO-1 with K.C.C. within 90 days of well completion, following instructions on ACO-1, side 1, and including copies of wireline logs.
 4. Notify District office 48 hours prior to old well workover or re-entry.
 5. Prior to plugging, prepare a plugging plan, then obtain agreement from the appropriate district office for an approved plugging plan.
 6. Submit plugging report (CP-4) to K.C.C. after plugging is completed.
 7. Obtain an approved injection docket number before disposing of salt water.
 8. Notify K.C.C. within 10 days when injection commences or terminates.
- If alternate 2 completion, cement in the production pipe from below any usable water to surface within 120 days of spud date.

RECEIVED
MAY 13 1985
05-13-1985
CONSERVATION DIVISION
Wichita, Kansas

State Corporation Commission of Kansas
Conservation Division
200 Colorado Derby Building
Wichita, Kansas 67202
(316) 263-3238