

CARD MUST BE TYPED

NOTICE OF INTENTION TO DRILL

CARD MUST BE SIGNED

State of Kansas
(see rules on reverse side)

Starting Date: 2nd / 14th / 85
month day year

API Number IS- 135-22,779-00-00

OPERATOR: License # 5073

C. E 1/2 SW Sec 12 Twp 17S Rge 26
(location) East West

Name Eagle Explorations, Inc.

Address Star Route

City/State/Zip Pratt, KS 67124

Contact Person Jack D. Fox

Phone 316-672-9451

1320 Ft North from Southeast Corner of Section

3300 Ft West from Southeast Corner of Section

(Note: Locate well on Section Plat on reverse side)

CONTRACTOR: License # 9087

Nearest lease or unit boundary line 1320 feet.

Name R&C Drilling Co. Inc.

County Ness

City/State Hays Kansas

Lease Name Quenzer Well# 5-12

Well Drilled For: Well Class: Type Equipment:

- | | | | |
|---|-------------------------------|---|--|
| <input checked="" type="checkbox"/> Oil | <input type="checkbox"/> Swd | <input type="checkbox"/> Infield | <input checked="" type="checkbox"/> Mud Rotary |
| <input type="checkbox"/> Gas | <input type="checkbox"/> Inj | <input checked="" type="checkbox"/> Pool Ext. | <input type="checkbox"/> Air Rotary |
| <input type="checkbox"/> OWWO | <input type="checkbox"/> Expl | <input type="checkbox"/> Wildcat | <input type="checkbox"/> Cable |

Domestic well within 330 feet: yes no

Municipal well within one mile: yes no

If OWWO: old well info as follows:

Operator

Well Name

Comp Date Old Total Depth

Projected Total Depth 4500 feet

Projected Formation at TD

Expected Producing Formations

Depth to Bottom of fresh water 40 feet

Lowest usable water formation Dakota

Depth to Bottom of usable water 900 feet

Surface pipe by Alternate: 1 2

Surface pipe to be set 900 feet

Conductor pipe if any required 0 feet

Ground surface elevation NA feet MSI

This Authorization Expires 8-6-85

Approved By 2-6-85 [Signature]

I certify that we will comply with K.S.A. 55-101, et seq., plus eventually plugging hole to K.C.C. specifications.


Date 1-30-85 Signature of Operator or Agent Jack D. Fox Title Drilling & Prod. Supv.

mhc/NOTE 2-6-85

Must be filed with the K.C.C. five (5) days prior to commencing well
This card void if drilling not started within six (6) months of date received by K.C.C.

Important procedures to follow:

**A Regular Section of Land
1 Mile = 5,280 Ft.**

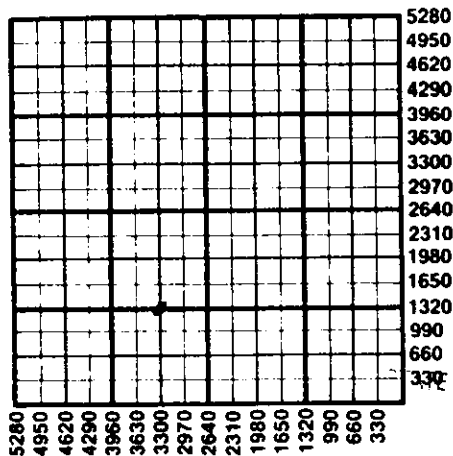

1. Notify District office before setting surface casing.
2. Set surface casing by circulating cement to the top.
3. File completion forms ACO-1 with K.C.C. within 90 days of well completion, following instructions on ACO-1, side 1, and including copies of wireline logs.
4. Notify District office 48 hours prior to old well workover or re-entry.
5. Prior to plugging, prepare a plugging plan, then obtain agreement from the appropriate district office for an approved plugging plan.
6. Submit plugging report (CP-4) to K.C.C. after plugging is completed.
7. Obtain an approved injection docket number before disposing of salt water.
8. Notify K.C.C. within 10 days when injection commences or terminates.
9. If an alternate 2 completion, cement in the production pipe from below any usable water to surface within 120 days of spud date.

FEB 06 1965

CONSERVATION DIVISION
Wichita, Kansas

State Corporation Commission of Kansas
Conservation Division
200 Colorado Derby Building
Wichita, Kansas 67202
(316) 263-3238