

NOTICE OF INTENTION TO DRILL

(see rules on reverse side)

Starting Date October 31 1986 month day year

API Number 15- 135-23,066-0000

OPERATOR: License # 5005 Name Sunburst Exploration Company, Inc. Address 112 Corporate Place, 125 N. Emporia City/State/Zip Wichita, Kansas 67202 Contact Person Ronald L. Irion Phone (316) 262-3041

SW SW SW Sec. 21 Twp. 17 S. Rg. 26 East West 440 Ft. from South Line of Section 4950 Ft. from East Line of Section

(Note: Locate well on Section Plat on reverse side)

CONTRACTOR: License # 5104 Name Blue Goose Drilling Co., Inc. City/State Great Bend, Kansas 67530

Nearest lease or unit boundary line 330 feet County Ness

Lease Name Miner Well # 1 Ground surface elevation 2454 feet MSL

Well Drilled For: Well Class: Type Equipment: Oil SWD Infield Mud Rotary Gas Inj Pool Ext Air Rotary OWWO Expl Wildcat Cable

Domestic well within 330 feet: yes no Municipal well within one mile: yes no Surface pipe by Alternate: 1 2 X Depth to bottom of fresh water 100 Depth to bottom of usable water 810 10.25 Surface pipe planned to be set 280 Projected Total Depth 4550 feet Formation Mississippian

If OWWO: old well info as follows:

Operator Well Name Comp Date Old Total Depth

I certify that well will comply with K.S.A. 55-101, et seq., plus eventually plugging hole to KCC specifications.

Date 10-17-86 Signature of Operator or Agent Ronald L. Irion Title Vice President

For KCC Use:

Conductor Pipe Required feet; Minimum Surface Pipe Required 200 feet per Alt.

This Authorization Expires 4-17-87 Approved By 10-17-86

Handwritten initials RCH/KCC


Handwritten initials and signature

Must be filed with the K.C.C. five (5) days prior to commencing well  
This card void if drilling not started within six (6) months of date received by K.C.C.

**Important procedures to follow:**

1. Notify District office before setting surface casing.
2. Set surface casing by circulating cement to the top.
3. File completion forms ACO-1 with K.C.C. within 90 days of well completion, following instructions on ACO-1, side 1, and including copies of wireline logs.
4. Notify District office 48 hours prior to old well workover or re-entry.
5. Prior to filing Intent, prepare a proposed plugging plan in case well is D & A, then obtain approval of plan when calling district office prior to setting surface pipe.
6. Submit plugging report (CP-4) to K.C.C. after plugging is completed.
7. Obtain an approved injection docket number before disposing of salt water.
8. Notify K.C.C. within 10 days when injection commences or terminates.
9. If an alternate 2 completion, cement in the production pipe from below any usable water to surface within 120 days of spud date.

**A Regular Section of Land  
1 Mile = 5,280 Ft.**

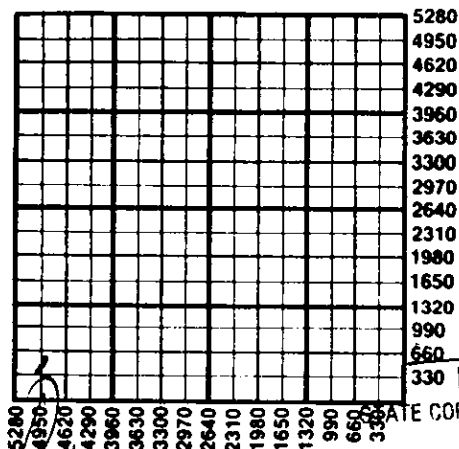

RECEIVED  
STATE CORPORATION COMMISSION

OCT 17 1986

CONSERVATION DIVISION  
Wichita, Kansas

State Corporation Commission of Kansas  
Conservation Division  
200 Colorado Derby Building  
Wichita, Kansas 67202  
(316) 263-3238