



KANSAS CORPORATION COMMISSION 1084146
OIL & GAS CONSERVATION DIVISION

Form ACO-1
June 2009
Form Must Be Typed
Form must be Signed
All blanks must be Filled

WELL COMPLETION FORM
WELL HISTORY - DESCRIPTION OF WELL & LEASE

OPERATOR: License # 33019
Name: Rosewood Resources, Inc.
Address 1: 2101 CEDAR SPRINGS RD, STE 1500
Address 2: _____
City: DALLAS State: TX Zip: 75201 + _____
Contact Person: Tom Roelfs
Phone: (214) 849-9300
CONTRACTOR: License # 33532
Name: Advanced Drilling Technologies LLC
Wellsite Geologist: Steven VonFeldt
Purchaser: _____

Designate Type of Completion:

- New Well Re-Entry Workover
- Oil WSW SWD SIOW
- Gas D&A ENHR SIGW
- OG GSW Temp. Abd.
- CM (Coal Bed Methane)
- Cathodic Other (Core, Expl., etc.): _____

If Workover/Re-entry: Old Well Info as follows:

Operator: _____
Well Name: _____
Original Comp. Date: _____ Original Total Depth: _____

Deepening Re-perf. Conv. to ENHR Conv. to SWD

Conv. to GSW

Plug Back: _____ Plug Back Total Depth _____

Commingled Permit #: _____

Dual Completion Permit #: _____

SWD Permit #: _____

ENHR Permit #: _____

GSW Permit #: _____

<u>11/09/2011</u>	<u>11/13/2011</u>	<u>01/18/2012</u>
Spud Date or Recompletion Date	Date Reached TD	Completion Date or Recompletion Date

API No. 15 - 15-181-20580-01-00

Spot Description: _____
NE NW NE NE Sec. 16 Twp. 7 S. R. 39 East West

225 Feet from North / South Line of Section

782 Feet from East / West Line of Section

Footages Calculated from Nearest Outside Section Corner:
 NE NW SE SW

County: Sherman

Lease Name: Stasser Well #: 41-16D

Field Name: _____

Producing Formation: Niobrara

Elevation: Ground: 3534 Kelly Bushing: 3546

Total Depth: 1482 Plug Back Total Depth: 1465

Amount of Surface Pipe Set and Cemented at: 349 Feet

Multiple Stage Cementing Collar Used? Yes No

If yes, show depth set: _____ Feet

If Alternate II completion, cement circulated from: _____
feet depth to: _____ w/ _____ sx cmt.

Drilling Fluid Management Plan

(Data must be collected from the Reserve Pit)

Chloride content: 5000 ppm Fluid volume: 200 bbls

Dewatering method used: Evaporated

Location of fluid disposal if hauled offsite: _____

Operator Name: _____

Lease Name: _____ License #: _____

Quarter _____ Sec. _____ Twp. _____ S. R. _____ East West

County: _____ Permit #: _____

AFFIDAVIT

I am the affiant and I hereby certify that all requirements of the statutes, rules and regulations promulgated to regulate the oil and gas industry have been fully complied with and the statements herein are complete and correct to the best of my knowledge.

Submitted Electronically

KCC Office Use ONLY

- Letter of Confidentiality Received
Date: _____
- Confidential Release Date: _____
- Wireline Log Received
- Geologist Report Received
- UIC Distribution
- ALT I II III Approved by: Deanna Garris Date: 06/21/2012



1084146

Operator Name: Rosewood Resources, Inc. Lease Name: Stasser Well #: 41-16D
 Sec. 16 Twp. 7 S. R. 39 East West County: Sherman

INSTRUCTIONS: Show important tops and base of formations penetrated. Detail all cores. Report all final copies of drill stems tests giving interval tested, time tool open and closed, flowing and shut-in pressures, whether shut-in pressure reached static level, hydrostatic pressures, bottom hole temperature, fluid recovery, and flow rates if gas to surface test, along with final chart(s). Attach extra sheet if more space is needed. Attach complete copy of all Electric Wire-line Logs surveyed. Attach final geological well site report.

Drill Stem Tests Taken <input type="checkbox"/> Yes <input checked="" type="checkbox"/> No <i>(Attach Additional Sheets)</i> Samples Sent to Geological Survey <input type="checkbox"/> Yes <input checked="" type="checkbox"/> No Cores Taken <input type="checkbox"/> Yes <input checked="" type="checkbox"/> No Electric Log Run <input checked="" type="checkbox"/> Yes <input type="checkbox"/> No Electric Log Submitted Electronically <input checked="" type="checkbox"/> Yes <input type="checkbox"/> No <i>(If no, Submit Copy)</i> List All E. Logs Run: Cement Bond Log	<input checked="" type="checkbox"/> Log Formation (Top), Depth and Datum <input type="checkbox"/> Sample <table style="width:100%; border-collapse: collapse;"> <tr> <td style="width:60%;">Name</td> <td style="width:20%;">Top</td> <td style="width:20%;">Datum</td> </tr> <tr> <td>Niobrara</td> <td>660</td> <td>KB</td> </tr> </table>	Name	Top	Datum	Niobrara	660	KB
Name	Top	Datum					
Niobrara	660	KB					

CASING RECORD <input checked="" type="checkbox"/> New <input type="checkbox"/> Used							
Report all strings set-conductor, surface, intermediate, production, etc.							
Purpose of String	Size Hole Drilled	Size Casing Set (In O.D.)	Weight Lbs. / Ft.	Setting Depth	Type of Cement	# Sacks Used	Type and Percent Additives
Surface	12.25	8.625	24	349	Neat	155	
Production	7.875	4.5	10.5	1467	Class A Type II	92	


ADDITIONAL CEMENTING / SQUEEZE RECORD				
Purpose:	Depth Top Bottom	Type of Cement	# Sacks Used	Type and Percent Additives
___ Perforate				
___ Protect Casing	-			
___ Plug Back TD				
___ Plug Off Zone	-			

Shots Per Foot	PERFORATION RECORD - Bridge Plugs Set/Type Specify Footage of Each Interval Perforated	Acid, Fracture, Shot, Cement Squeeze Record (Amount and Kind of Material Used)	Depth
4	1324-1394	Frac with 48,936 gals MavFoam 70 & 100,080# 16/30 Daniel Sand and 280,000 SCF N2	

TUBING RECORD:	Size:	Set At:	Packer At:	Liner Run: <input type="checkbox"/> Yes <input type="checkbox"/> No
----------------	-------	---------	------------	---

Date of First, Resumed Production, SWD or ENHR. <u>01/18/2012</u>		Producing Method: <input checked="" type="checkbox"/> Flowing <input type="checkbox"/> Pumping <input type="checkbox"/> Gas Lift <input type="checkbox"/> Other (Explain) _____			
Estimated Production Per 24 Hours	Oil Bbls.	Gas Mcf	Water Bbls.	Gas-Oil Ratio	Gravity
		45			

DISPOSITION OF GAS: <input type="checkbox"/> Vented <input checked="" type="checkbox"/> Sold <input type="checkbox"/> Used on Lease <i>(If vented, Submit ACO-18.)</i>	METHOD OF COMPLETION: <input type="checkbox"/> Open Hole <input checked="" type="checkbox"/> Perf. <input type="checkbox"/> Dually Comp. <input type="checkbox"/> Commingled <i>(Submit ACO-5)</i> <i>(Submit ACO-4)</i> <input type="checkbox"/> Other (Specify) _____	PRODUCTION INTERVAL: _____ _____
--	--	--

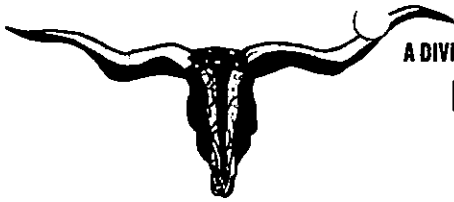

A DIVISION OF ADVANCED DRILLING TECHNOLOGIES, LLC.

LONGHORN CEMENTING CO.

P.O. BOX 203 YUMA, COLORADO 80759
Phone: 970-848-0789 Fax: 970-848-0788

**FIELD SERVICE TICKET
AND INVOICE**

DATE 11-13-11 TICKET NO. 2502

DATE OF JOB	DISTRICT	NEW WELL <input checked="" type="checkbox"/>	OLD WELL <input type="checkbox"/>	PROD <input type="checkbox"/>	INJ <input type="checkbox"/>	WDW <input type="checkbox"/>	CUSTOMER ORDER NO.:			
CUSTOMER <u>Rosewood</u>		LEASE <u>Staggs 41-16D</u>					WELL NO.			
ADDRESS		COUNTY			STATE					
CITY		STATE		SERVICE CREW <u>Mike E. Rob S.</u>						
AUTHORIZED BY		EQUIPMENT <u>UNIT #112</u>								
TYPE JOB: <u>1 1/2" casing to depth</u>	DEPTH FT.	CEMENT DATA: BULK <input type="checkbox"/>			SAND DATA: SACKS <input type="checkbox"/>		TRUCK CALLED	DATE	AM	TIME
		SACKS	BRAND	TYPE	% GEL	ADMIXES				
SIZE HOLE: <u>4 1/2"</u>	DEPTH FT.	<u>92</u>	<u>A</u>	<u>1-11</u>			ARRIVED AT JOB		AM	PM
SIZE & WT. CASING	DEPTH FT.						START OPERATION		AM	PM
SIZE & WT. O PIPE OR TUBING	DEPTH FT.						FINISH OPERATION		AM	PM
TOP PLUGS	TYPE	WEIGHT OF SLURRY: <u>14.877</u> LBS. / GAL.		LBS. / GAL.			RELEASED		AM	PM
		VOLUME OF SLURRY: <u>1.52</u> CBFT					MILES FROM STATION TO WELL			
<u>1416</u>	MAX DEPTH FT.	SACKS CEMENT TREATED WITH		% OF						
		MAX PRESSURE		PSI						

CONTRACT CONDITIONS: (This contract must be signed before the job is commenced or merchandise is delivered).
The undersigned is authorized to execute this contract as an agent of the customer. As such, the undersigned agrees and acknowledges that this contract for services, materials, products, and/or supplies includes all of and only these terms and conditions appearing on the front and back of this document. No additional or substitute terms and/or conditions shall become a part of this contract without written consent of an officer of Advanced Drilling Technologies, LLC.

SIGNED: _____
(WELL OWNER, OPERATOR, CONTRACTOR OR AGENT)

ITEM / PRICE REF. NUMBER	MATERIAL, EQUIPMENT AND SERVICES USED	UNIT	QUANTITY	UNIT PRICE	\$ AMOUNT
001-d	Depth charge - Cement - Milano				
300-2	4 1/2" Accused Flouther		7		
300-4	4 1/2" Latex/Carbon Based plug		2		
300-6	4 1/2" Centralizers		10		
300-10					
400-2	KCl		1000		
	Freshment 10 BBIS				
	Cement 21.6 BBIS				
	Displacement 23.3 BBIS				
	Bumped plug 2000				

ACID DATA:			
	GALLONS	%	ADDITIVES
HCL			
HCL			

SERVICE & EQUIPMENT	%TAX ON \$
MATERIALS	%TAX ON \$
TOTAL	

SERVICE REPRESENTATIVE: [Signature] THE ABOVE MATERIAL AND SERVICE ORDERED BY CUSTOMER AND RECEIVED BY: [Signature]
FIELD SERVICE ORDER NO. _____ (WELL OWNER, OPERATOR, CONTRACTOR OR AGENT)

Directional Drilling Report

Customer: Advanced Drilling Technologies

Address: Advanced Drilling Technologies, LLC
529 North Albany Street
Suite 1250
Yuma, CO 80759

Well Name: Stasser 41-16D
Survey Name: AnTech Stasser Gyro Survey
Date: 13/11/2011

AnTech Ltd
Unit 7, Newbery Centre
Airport Business Park
Exeter. EX5 2UL. UK

Tel: +44 (0)1392 440300
Email: antech@antech.co.uk
www.antech.co.uk
www.coiledtubingdrilling.com

Summary

Customer:	Advanced Drilling Technologies	Motor Bend Angle:	1.83
Project:	Polaris Operational Trials	Local Co-ordinate Reference:	GPS
Site:	Stasser	TVD Reference:	Minimum Curvature Calculation
Well:	Stasser 41-16D	MD Reference:	Pason Bit Depth
Bit & Nozzle Size:	6 1/2"	North Reference:	Gyro True North
Drill Motor:	Hunting 5", 7/8, 4.5, 0.46RPG	Survey Calculation Method:	Minimum Curvature

Well

Northing [ft]:	-654.09	Deviation In Azimuth Direction [ft]:	727.02
Easting [ft]:	317.4	Maximum Inclination:	69.67
SHL Latitude:	39°27'08"N	Survey Inclination Error:	±0.15
SHL Longitude:	101°40'20"W	Survey Azimuth Error:	±3
		Deviation from Plan at Zone Entry [ft]:	75.18
		Deviation from Plan at TD [ft]:	21.11




Casing Diagram

Customer:	Advanced Drilling Technologies	Motor Bend Angle:	1.83
Project:	Polaris Operational Trials	Local Co-ordinate Reference:	GPS
Site:	Stasser	TVD Reference:	Minimum Curvature Calculation
Well:	Stasser 41-16D	MD Reference:	Pason Bit Depth
Bit & Nozzle Size:	6 1/2"	North Reference:	Gyro True North
Drill Motor:	Hunting 5", 7/8, 4.5, 0.46RPG	Survey Calculation Method:	Minimum Curvature

Depth (ft)	Hole Size (in)	Casing				Cement	Completion Comments
		Size (in)	Weight (ppf)	Grade	Thread		
350	9.875	8.625	24	J-55		Neat	8hrs to work
1468	6.5	4.5	10.5	J-55		Neat	

	Diameter (in)	Start Depth (TVD)	End Depth (TVD)
Initial hole size	9.88		350.0
Initial casing	8.63		350.0
Secondary hole size	6.50	350.0	1101.0
Secondary casing	4.50	350.0	1101.0
Tertiary hole size		1101.0	1101.0
Tertiary casing		1101.0	1101.0

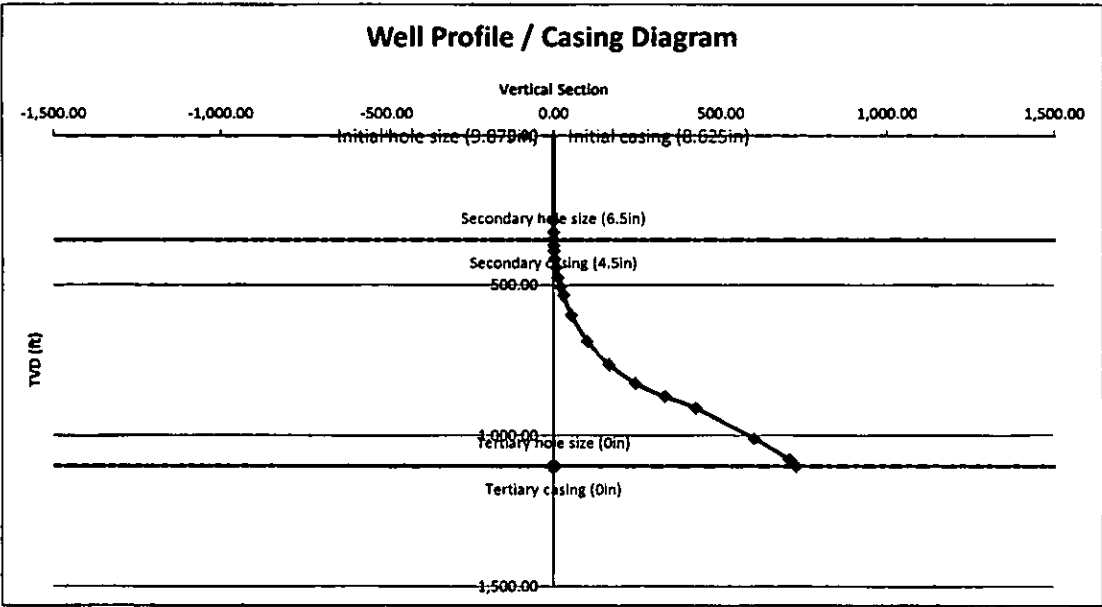



Well Data

Customer:	Advanced Drilling Technologies	Motor Bend Angle:	1.83
Project:	Polaris Operational Trials	Local Co-ordinate Reference:	GPS
Site:	Stasser	TVD Reference:	Minimum Curvature Calculation
Well:	Stasser 41-16D	MD Reference:	Pason Bit Depth
Bit & Nozzle Size:	6 1/2"	North Reference:	Gyro True North
Drill Motor:	Hunting 5", 7/8, 4.5, 0.46RPG	Survey Calculation Method:	Minimum Curvature

Formation Tops

Name	TVD [ft]	Data Points Direction	Distance [ft]	Dip distance (χ) (Dip=1'/χ)
TOP BIZ	1005	N-S	3000	5000



Well Plan Data

Customer:	Advanced Drilling Technologies	Motor Bend Angle:	1.83
Project:	Polaris Operational Trials	Local Co-ordinate Reference:	GPS
Site:	Stasser	TVD Reference:	Minimum Curvature Calculation
Well:	Stasser 41-16D	MD Reference:	Pason Bit Depth
Bit & Nozzle Size:	6 1/2"	North Reference:	Gyro True North
Drill Motor:	Hunting 5", 7/8, 4.5, 0.46RPG	Survey Calculation Method:	Minimum Curvature

Final Bearing / Azimuth for section view (")	154.48
--	--------

Projected TD Survey

Measured Depth ft	Inclination Angle degrees	Azimuth degrees	True Vertical Depth ft	North/South ft	East/West ft	Vertical Section ft	Dogleg Severity /100ft	Reference	Description	Section
0.00	0.00	0.00	0.00	0.00	0.00	0.00	0.00	SKN	tie point	0
100.00	0.00	0.00	100.00	0.00	0.00	0.00	0.00		vertical	0-1
200.00	0.00	0.00	200.00	0.00	0.00	0.00	0.00		vertical	0-1
300.00	0.00	0.00	300.00	0.00	0.00	0.00	0.00		vertical	0-1
325.00	0.00	0.00	325.00	0.00	0.00	0.00	0.00	SCF	End Vertical	1
400.00	7.50	154.48	399.79	-4.42	2.11	4.90	10.00		build	1-2
500.00	17.50	154.48	497.29	-23.93	11.42	26.52	10.00		build	1-2
600.00	27.50	154.48	589.56	-58.42	27.89	64.74	10.00		build	1-2
700.00	37.50	154.48	673.79	-106.85	51.01	118.40	10.00		build	1-2
800.00	47.50	154.48	747.43	-167.74	80.08	185.87	10.00		build	1-2
860.00	53.50	154.48	785.58	-209.50	100.02	232.15	10.00		End build	2
1000.00	53.50	154.48	858.85	-311.06	148.50	344.69	0.00		straight	2-3
1100.00	53.50	154.48	928.33	-383.60	183.13	425.08	0.00		straight	2-3
1200.00	53.50	154.48	987.82	-456.15	217.77	505.46	0.00		straight	2-3
1228.83	53.50	154.48	1,005.00	-477.10	227.77	528.68	0.00	TOP OF BIX	straight	2-3
1300.00	53.50	154.48	1,047.30	-528.69	252.40	585.85	0.00		straight	2-3
1400.00	53.50	154.48	1,106.78	-601.23	287.03	666.23	0.00		straight	2-3
1450.00	53.50	154.48	1,136.52	-637.50	304.35	706.42	0.00	TD	End Straight	3



Drilling Data

Customer:	Advanced Drilling Technologies	Motor Bend Angle:	1.83
Project:	Polaris Operational Trieb	Local Co-ordinate Reference:	GPS
Site:	Stasser	TVD Reference:	Minimum Curvature Calculation
Well:	Stasser 41-160	MD Reference:	Pason Bit Depth
Bit & Nozzle Size:	6 1/2"	North Reference:	Oyro True North
Drill Motor:	Hunting 5", 7/8, 4.5, 0.66RPG	Survey Calculation Method:	Minimum Curvature





Final Bearing / Azimuth for section view (°)	154.44
--	--------

Actual Survey Data													
Measured Depth	Bit Depth	Inclination Angle	Azimuth	True Vertical	North/South	East/West	Vertical Section	Dogleg Severity	Reference	Description	Time	Date	
ft	ft (MD +30 ft)	degrees	degrees	ft	ft	ft	ft	"/100ft					
38.00	0.00	0.00	0.00	-30.00	0.00	0.00	0.00	0.00			06:10	12/11/2011	
267.00	327.04	0.00	0.04	287.00	0.00	0.00	0.00	0.00	Tag cement	vertical			
323.97	393.97	0.00	0.00	323.97	0.00	0.00	0.00	0.00	Kick Off	build			
347.80	377.80	0.79	188.83	347.00	-0.14	0.08	0.16	3.43	build & rotate	build	08:55		
347.00	397.00	3.69	100.30	366.98	-0.58	0.70	0.83	15.13	build & rotate	build	09:30		
307.00	417.00	5.31	107.49	386.92	-1.11	2.16	1.93	10.64	build & rotate	build	10:46		
413.00	441.00	9.32	160.45	412.71	-2.03	5.31	4.12	15.31	build & rotate	build	11:15		
443.00	473.00	10.05	119.34	442.26	-3.89	10.11	7.86	5.18	build & rotate	build	11:54		
477.93	507.93	12.29	139.37	476.52	-7.81	15.66	13.79	13.34	build & rotate	build	12:26		
808.74	838.74	15.90	141.81	506.39	-13.45	20.61	21.02	12.85	build & rotate	build	13:00		
838.00	868.00	18.18	141.91	534.36	-20.16	25.98	29.39	7.52	build & rotate	build	13:51		
606.00	438.00	21.87	191.40	600.51	-41.23	39.68	54.30	9.13	build & rotate	build	23:57		
709.00	739.00	24.82	184.21	687.33	-84.16	60.42	101.98	10.78	build & rotate	build	21:30		
858.47	888.47	26.00	184.17	764.30	-142.84	87.44	166.58	11.95	build & rotate	build	22:21		
909.87	939.87	27.64	147.14	826.79	-211.92	126.44	245.72	12.85	build & rotate	build	23:17		
1309.00	1339.00	49.47	190.04	870.25	-287.24	171.49	333.10	12.70	build & rotate	build	00:10	13/11/2011	
1167.34	1137.34	69.04	169.82	908.58	-369.18	212.95	424.91	6.32	build & rotate	drop	01:36		
1310.00	1340.00	85.49	141.20	1,009.35	-532.76	278.30	600.68	5.31	Back Survey	drop	06:45		
1437.95	1467.95	82.00	143.12	1,078.46	-633.00	313.83	706.45	4.14	TD	TD	06:27		
1467.95	N/A	81.00	143.12	1,101.22	-654.09	317.40	727.02	1.84	Extrapolated as a straight line				




Summary Well Plots

Customer:	Advanced Drilling Technologies	Motor Bend Angle:	1.83
Project:	Polaris Operational Trials	Local Co-ordinate Reference:	GPS
Site:	Stasser	TVD Reference:	Minimum Curvature Calculation
Well:	Stasser 41-16D	MD Reference:	Pason Bit Depth
Bit & Nozzle Size:	6 1/2"	North Reference:	Gyro True North
Drill Motor:	Hunting 5", 7/8, 4.5, 0.46RPG	Survey Calculation Method:	Minimum Curvature

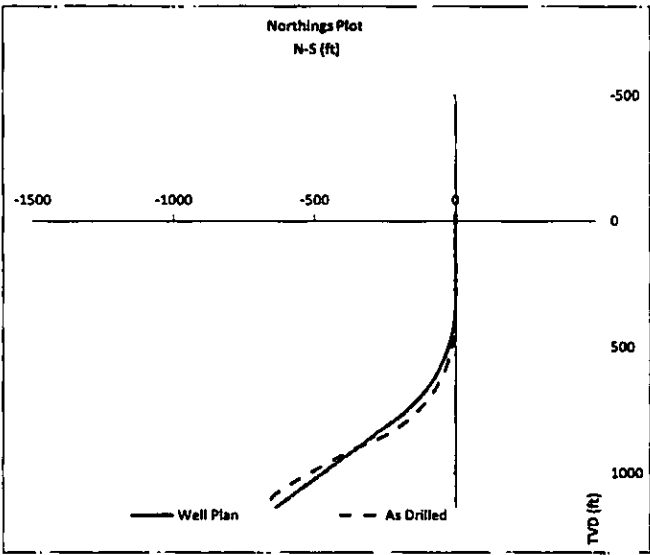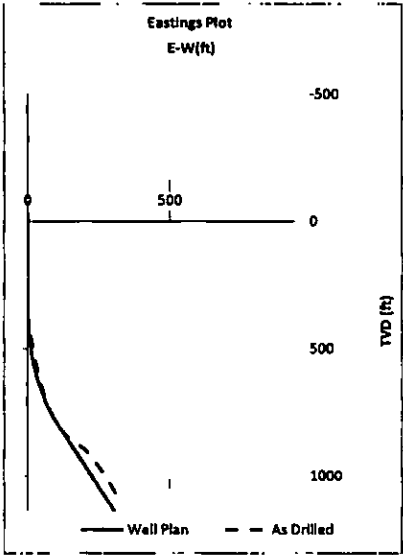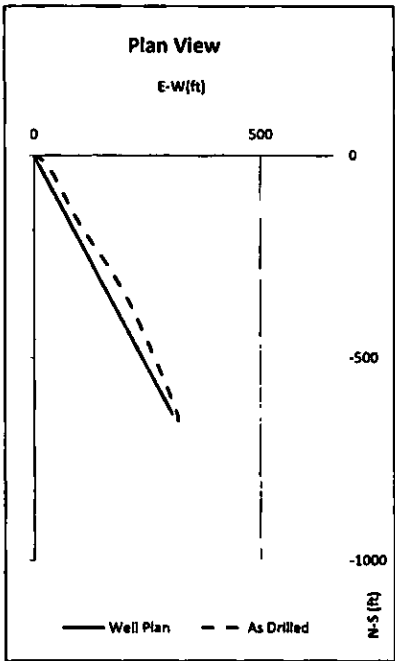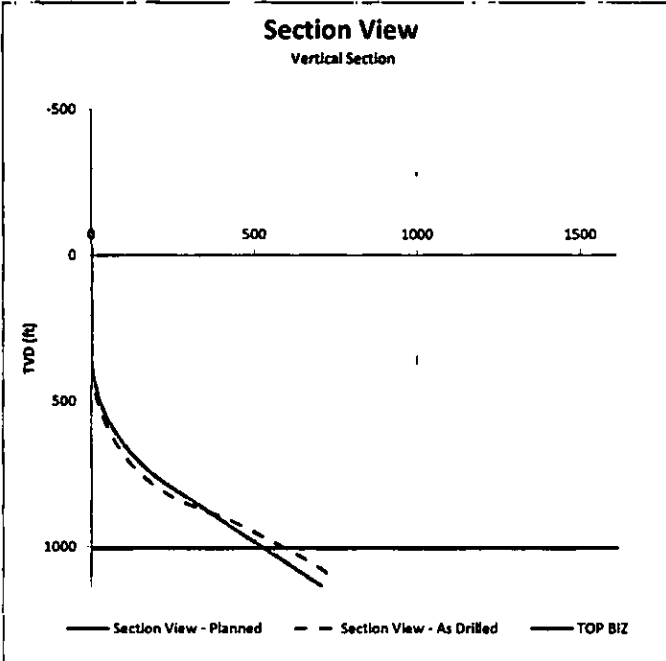

Section View

Vertical Section

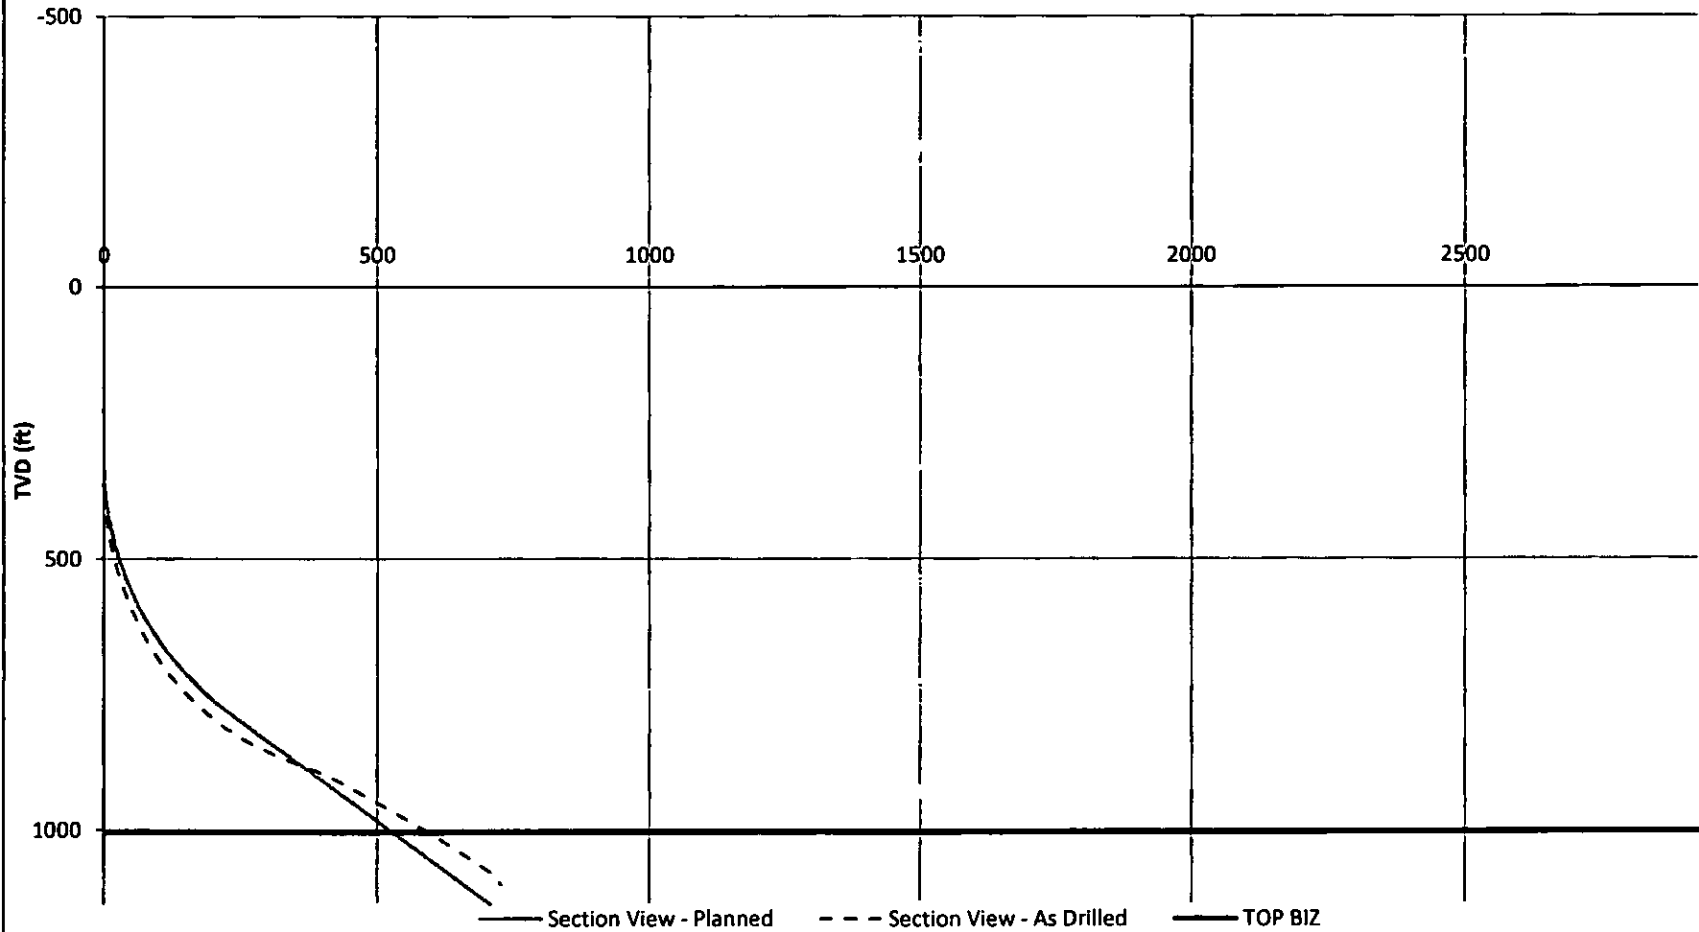


AnTech™

Plan Plot

E-W(ft)

ADVANCED
DRILLING

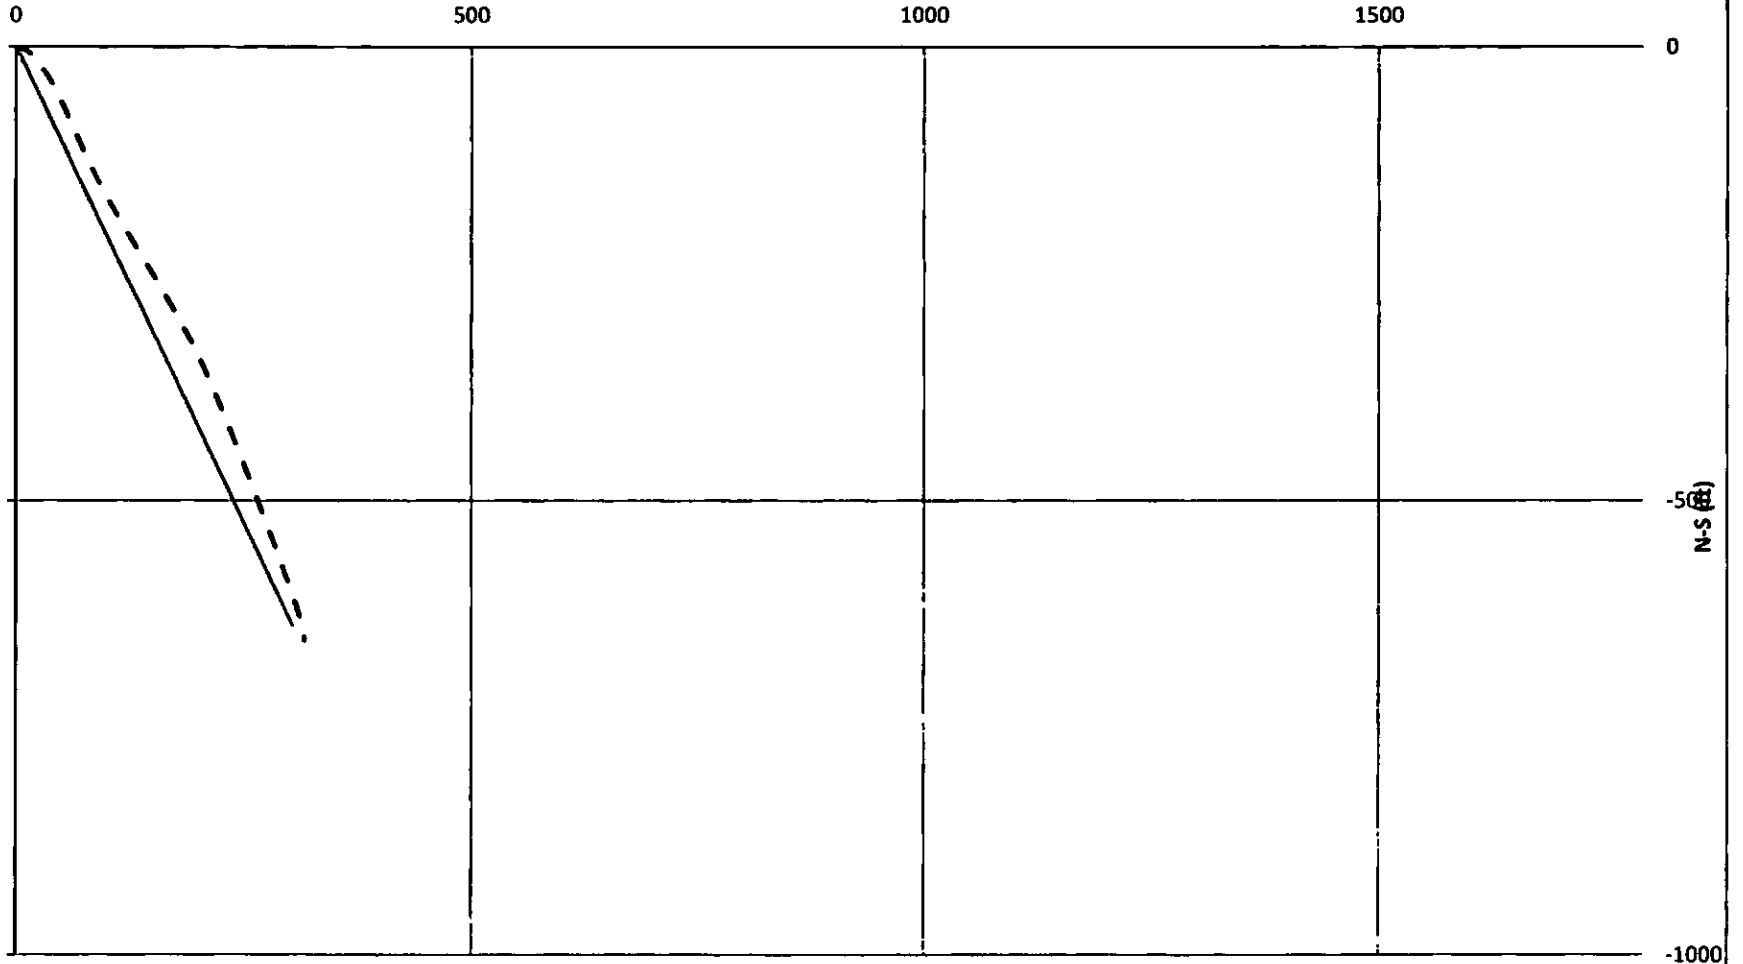


— Well Plan - - As Drilled

AnTech

Northings Plot

ADVANCED
DRILLING
TECHNOLOGIES

N-S (ft)

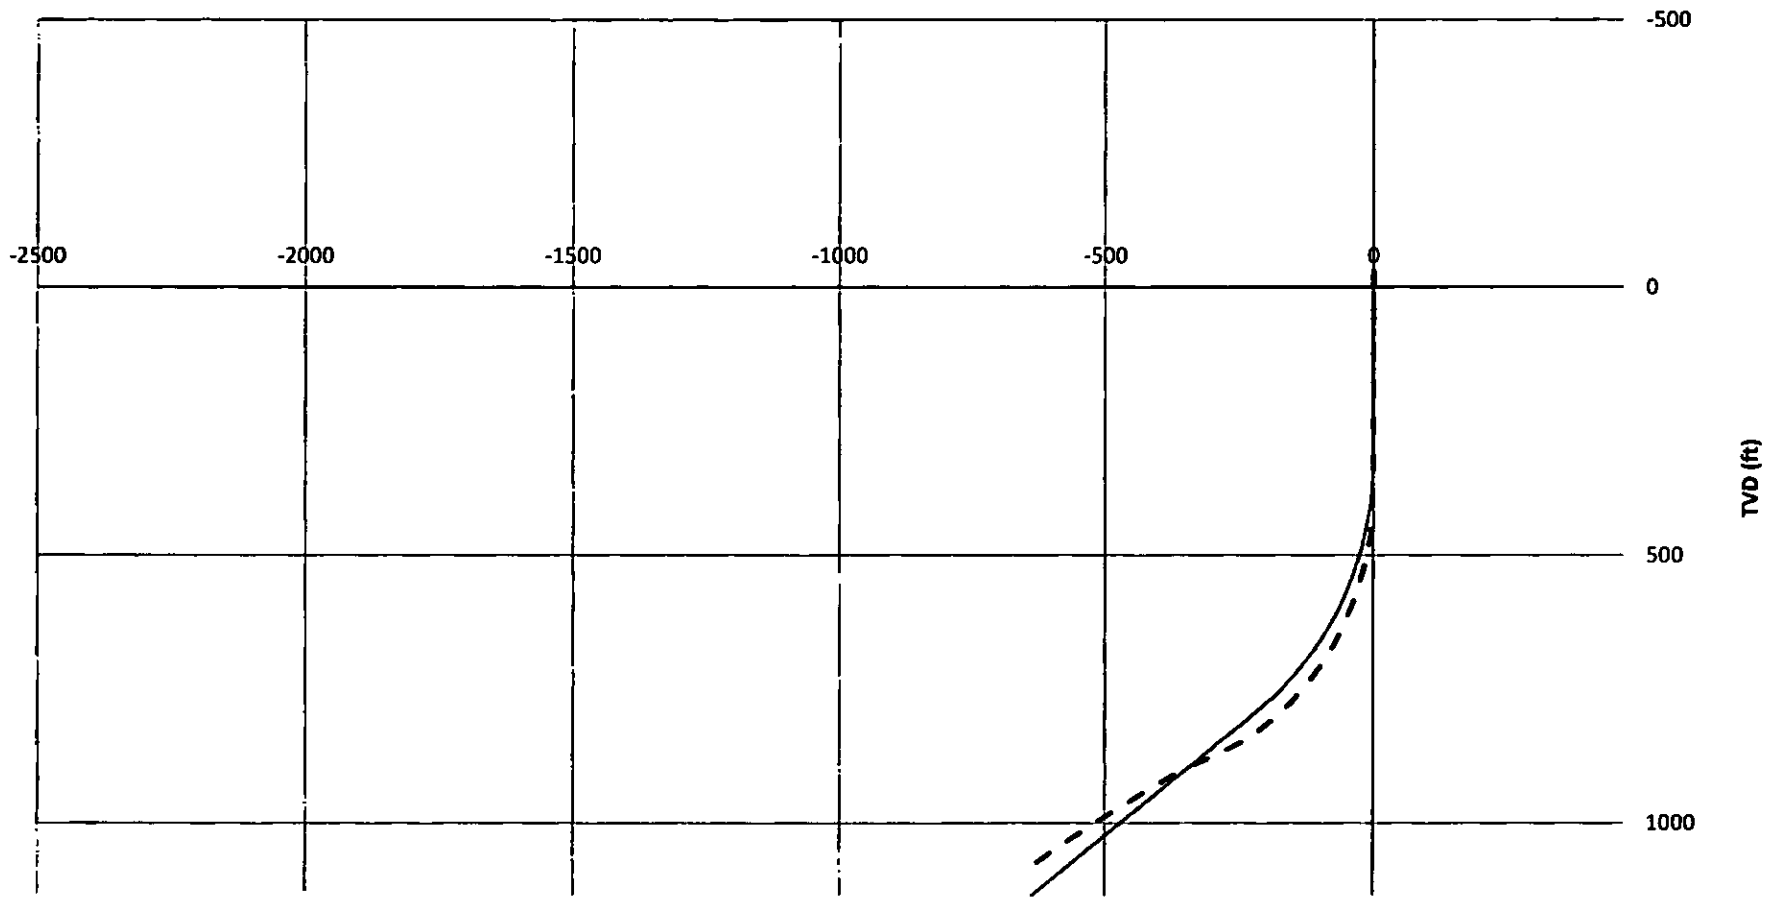

— Well Plan


- - As Drilled

AnTech

Eastings Plot

ADVANCED
DRILLING
TECHNOLOGIES

E-W(ft)

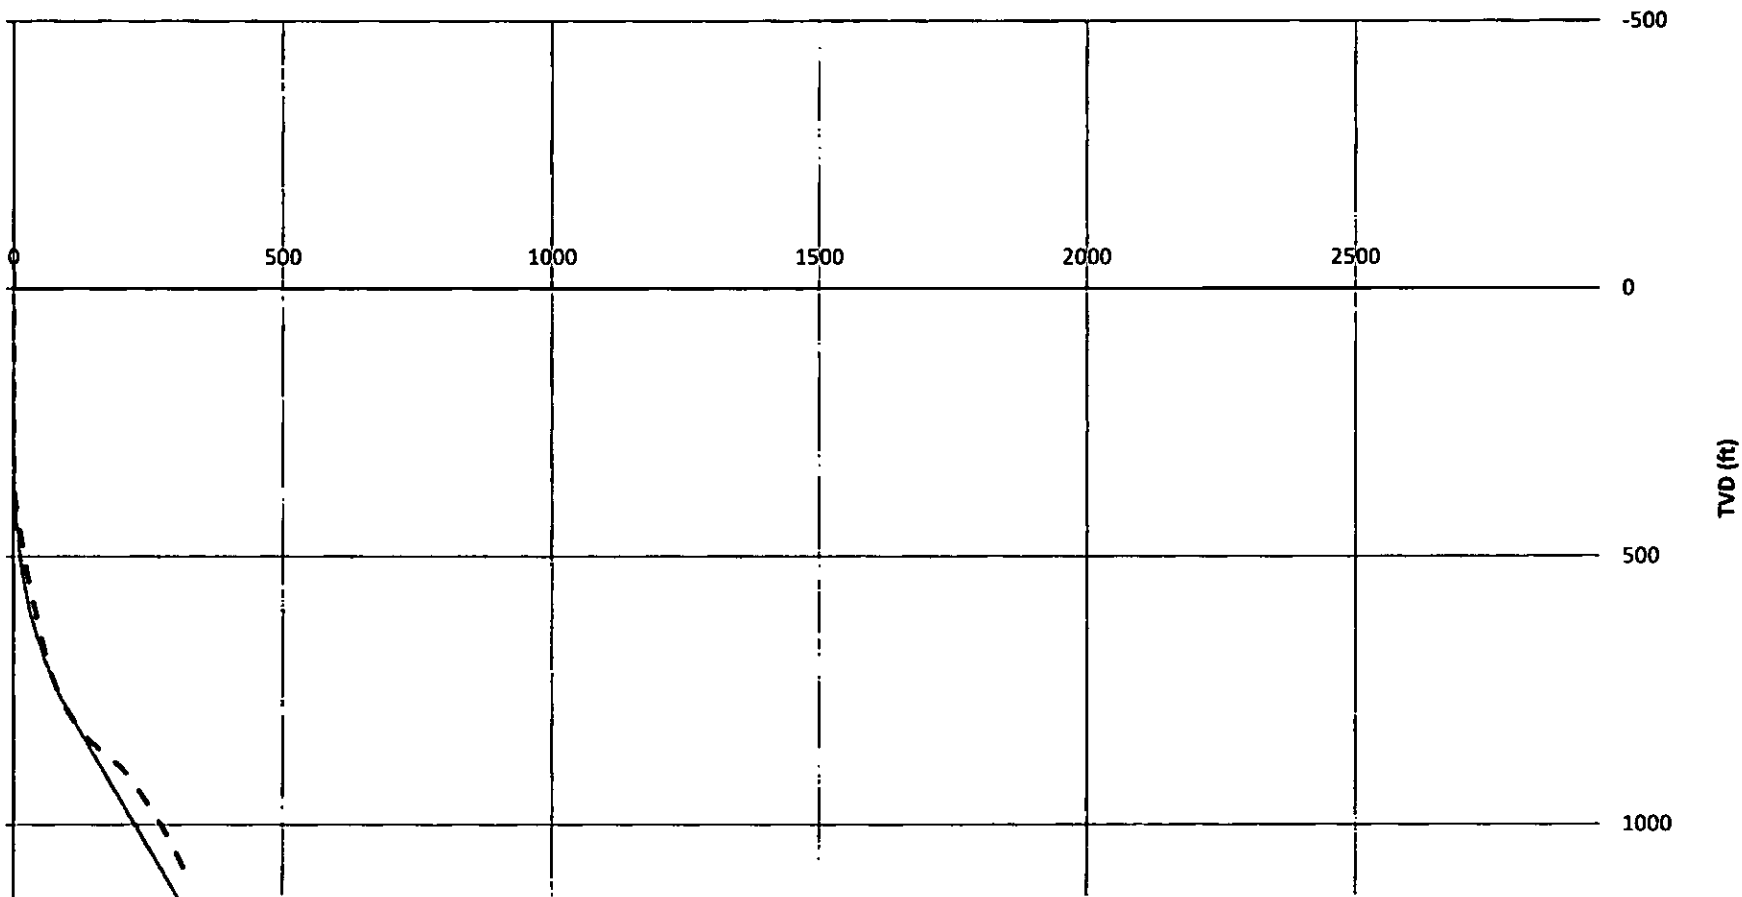

— Well Plan

- - As Drilled





Directional Drilling Morning Report

DATE: 09/11/2011
TIME: 10:31

Customer:	Advanced Drilling Technologies	Motor Bend Angle:	1.83
Project:	Polaris Operational Trials	Local Co-ordinate Reference:	GPS
Site:	Stasser	TVD Reference:	Minimum Curvature Calculation
Well:	Stasser 41-16D	MD Reference:	Pason Bit Depth
Bit & Nozzle Size:	6 1/2"	North Reference:	Gyro True North
Drill Motor:	Hunting 5", 7/8, 4.5, 0.46RPG	Survey Calculation Method:	Minimum Curvature

Event Log

Time	Date	Measured Depth [ft]	Description	Inclination	Azimuth	Pump Rate [GPM]	Mud Weight [PPG]
06:10	08/11/2011		RIH				
08:18		353.97	Set up surveys complete (Toolface - 154.93)	1.33			
08:20			Drill 20ft @154.93 tool face, no rotation, build only				
09:23		377.10	Survey (Toolface - 150.83) orient toolface to 154	0.79			
09:50			Drill 20ft @154.93 tool face, no rotation, build only				
10:15		397.00	Survey (Toolface - 122.09) NOTE - Keep putting left	3.71	122.09		
10:38			Drill 20ft @154.93 tool face, no rotation, build only				
10:53		413.59	Survey - Now above 5 deg inc	5.12	102.49		
11:00			Drill 30ft @ 45 deg toolface				
11:30		443.75	Survey	9.22	108.65		
11:30			Drill 30ft @ 90 deg toolface				
11:54		474.39	Survey	10.54	119.34		
12:00			Drill 30ft @60 deg toolface				
12:26		507.00	Survey	12.29	135.37		
12:30			Drill 30ft @ 45 deg toolface				
13:00		538.74	Survey	15.98	141.31		
13:08			Drill straight with orienter rotation for 30ft				
13:51		568.00	Survey	18.37	140.21		
14:00			Drill 70ft @ 0 tool face (build)				
14:36			Tool failure - tool leaking current, orienter rotation failed				
14:37		638.00	Survey	23.57	151.40		
14:40			POOH, swap tools, replace cablehead				
20:00			RIH with new tool				
20:45		638.00	Check last survey	24.70	152.99		
20:52			Drill @ 15 deg tool face to build for 100ft				
21:20		737.00	Survey	34.02	156.23		
21:40			Drill @ 20 deg tool face to build for 100ft				
22:21		838.67	Survey	46.00	154.53		
22:25			Drill @ 0 deg tool face to build for 100ft				
23:17		939	Survey	57.66	147.16		
23:30			Drill 70ft @ 20 deg toolface, rotate for 30ft				
00:17	09/11/2011	1038	Survey	69.67	150.88		
01:34		1138	Survey	63.08	155.52		
01:40			Drill 60ft @ 145deg toolface, rotate for 40ft				
02:45		1250	In zone. Drill straight to TD, Survey on POOH				
06:22		1340.8	Survey @ TD	55.45	161.2		
06:45		1340.8	Back Survey	55.45	161.2		
07:00			POOH, Rig down				

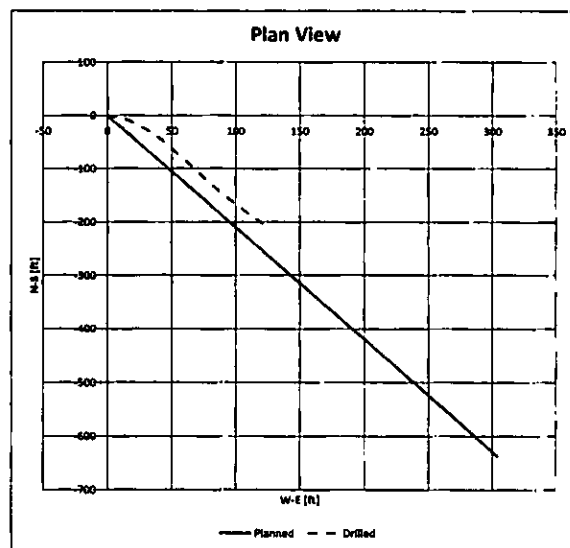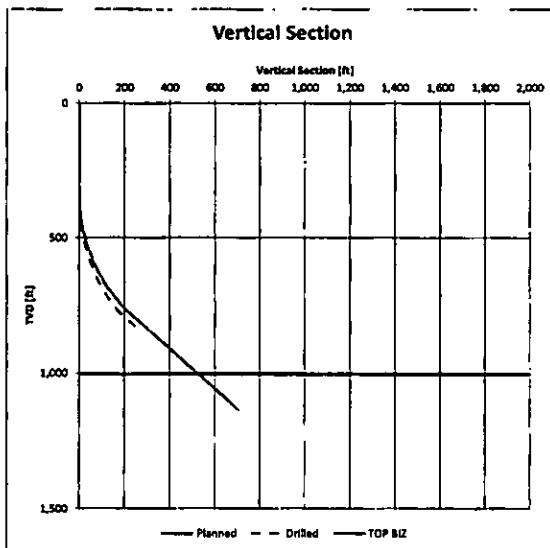

AnTech™

**ADVANCED
DRILLING**

DEPTH ft	h (MD+30 ft)	Angle degrees	Azimuth degrees	True Vertical Depth ft	North/South ft	East/West ft	Vertical Section ft	Dogleg Severity "/100ft	Reference	Description	Time	
10.00	0.00	0.00	0.00	-10.00	0.00	0.00	0.00	0.00		KB		12/11/2011
207.00	217.00	0.00	0.00	207.00	0.00	0.00	0.00	0.00	Tag cement	vertical		
223.07	253.07	0.00	0.00	223.07	0.00	0.00	0.00	0.00	Kick Off	build		
247.00	277.00	0.79	180.82	247.00	-0.18	0.08	0.16	3.43	build & rotate	build	08:25	
267.00	297.00	3.40	120.30	266.99	-0.58	0.70	0.93	15.13	build & rotate	build	09:30	
287.00	417.00	8.21	102.49	286.92	-1.11	2.10	3.93	10.64	build & rotate	build	10:48	
413.00	443.00	9.22	108.63	412.71	-2.03	8.31	4.12	15.31	build & rotate	build	11:18	
443.00	473.00	10.55	113.34	442.26	-3.09	10.11	7.06	8.10	build & rotate	build	11:54	
477.01	507.01	12.20	119.37	476.82	-7.01	15.64	13.79	13.34	build & rotate	build	12:24	
509.74	529.74	14.00	141.31	508.39	-13.45	20.61	21.02	12.03	build & rotate	build	13:00	
538.00	568.00	16.18	141.31	536.36	-20.16	25.08	29.39	7.52	build & rotate	build	13:51	
609.00	639.00	23.57	151.40	608.81	-41.23	39.68	54.38	9.23	build & rotate	build	21:07	
708.00	738.00	24.02	154.21	697.33	-44.16	40.42	101.98	10.70	build & rotate	build	21:30	
808.07	838.07	46.00	184.51	764.30	-142.84	87.64	164.88	11.90	build & rotate	build	22:21	
809.07	839.07	57.64	147.16	826.79	-213.92	126.44	248.72	12.65	build & rotate	build	23:27	
1008.00	1038.00	49.67	186.08	870.29	-247.24	171.49	333.10	12.70	build & rotate	build	00:16	12/11/2011
1107.86	1137.86	68.04	165.82	908.88	-269.10	212.95	424.91	6.32	build & rotate	drop	01:36	
1210.00	1240.00	55.48	161.20	1009.35	-532.76	278.30	600.64	5.31	Back Survey	drop	06:45	
1417.95	1467.95	83.00	143.11	1070.46	-633.00	312.03	706.45	4.14	TD	TD	06:27	
1467.95	N/A	83.00	143.11	1101.22	-654.00	317.40	727.02	1.84	Extrapolated as a straight line	0.00		