

FOR KCC USE:

FORM C-1 7/91

EFFECTIVE DATE: 1-27-2001

FORM MUST BE TYPED

DISTRICT # 4

State of Kansas

FORM MUST BE SIGNED

SGA7... Yes  No

NOTICE OF INTENTION TO DRILL

ALL BLANKS MUST BE FILLED

Must be approved by the K.C.C. five (5) days prior to commencing well.

Expected Spud Date 1 24 2001  
month day year

Spot SE NE NW Sec 27 Twp 11 S, Rg 19 East  West

OPERATOR: License # 5259  
Name: MAT OIL OPERATIONS, INC.  
Address: P.O. BOX 33  
City/State/Zip: RUSSELL, KS. 67665  
Contact Person: ALLEN BANGERT  
Phone: 785-483-2169

990 feet from South / North line of Section  
2310 feet from East / West line of Section  
IS SECTION  REGULAR  IRREGULAR

(NOTE: Locate well on the Section Plat on Reverse Side)

CONTRACTOR: License # 30606  
Name: MURFIN DRILLING CO., INC.

County: ELLIS  
Lease Name: VINE Well #: 7  
Field Name: SOLOMON

Is this a Prorated/Spaced Field? ... yes  no

Target Formation(s): ARBUCKLE

Nearest lease or unit boundary: 330'

Ground Surface Elevation: 2120 EST feet MSL

Water well within one-quarter mile: ... yes  no

Public water supply well within one mile: ... yes  no

Depth to bottom of fresh water: 180'

Depth to bottom of usable water: 200'

Surface Pipe by Alternate: ... 1  2

Length of Surface Pipe Planned to be set: 200'

Length of Conductor pipe required: NONE

Projected Total Depth: 3650'

Formation at Total Depth: ARBUCKLE

Water Source for Drilling Operations:

... well ... farm pond  other

Well Drilled For:	Well Class:	Type Equipment:
<input checked="" type="checkbox"/> Oil	<input checked="" type="checkbox"/> Infield	<input checked="" type="checkbox"/> Mud Rotary
... Gas	... Pool Ext.	... Air Rotary
... OWMO	... Wildcat	... Cable
... Seismic; ... # of Holes	... Other	

f OWMO: old well information as follows:

Operator: .....

Well Name: .....

Comp. Date: ..... Old Total Depth .....

irectional, Deviated or Horizontal wellbore? ... yes  no

f yes, true vertical depth: .....

ottom Hole Location: .....

Will Cores Be Taken?: ... yes  no

If yes, proposed zone: .....

AFFIDAVIT

I, undersigned hereby affirms that the drilling, completion and eventual plugging of this well will comply with K.S.A. 55-101, et seq.

I am agreed that the following minimum requirements will be met:

1. Notify the appropriate district office prior to spudding of well;
2. A copy of the approved notice of intent to drill shall be posted on each drilling rig;
3. The minimum amount of surface pipe as specified below shall be set by circulating cement to the top; in all cases surface pipe shall be set through all unconsolidated materials plus a minimum of 20 feet into the underlying formation;
4. If the well is dry hole, an agreement between the operator and the district office on plug length and placement is necessary prior to plugging;
5. The appropriate district office will be notified before well is either plugged or production casing is cemented in;
6. IF AN ALTERNATE II COMPLETION, PRODUCTION PIPE SHALL BE CEMENTED FROM BELOW ANY USABLE WATER TO SURFACE WITHIN 120 DAYS OF SPUD DATE. IN ALL CASES, NOTIFY DISTRICT OFFICE PRIOR TO ANY CEMENTING.

I hereby certify that the statements made herein are true and to the best of my knowledge and belief.

Signature of Operator or Agent: Allen Bangert Title: PROD. SUPT.

FOR KCC USE:  
 API # 15- 051-25075-0000  
 Conductor pipe required NONE feet  
 Minimum surface pipe required 200 feet per Alt.  (2)  
 Approved by: JK 1-22-2001  
 This authorization expires: 7-22-2001  
 (This authorization void if drilling not started within 6 months of effective date.)  
 Spud date: \_\_\_\_\_ Agent: \_\_\_\_\_

RECEIVED  
STATE CORPORATION COMMISSION

JAN 18 2001

CONSERVATION DIVISION  
Wichita, Kansas

MEMBER TO:

- File Drill Pit Application (form CDP-1) with Intent to Drill;
- File Completion Form ACO-1 within 120 days of spud date;
- File acreage attribution plat according to field proration orders;
- Notify appropriate district office 48 hours prior to workover or re-entry;
- Submit plugging report (CP-4) after plugging is completed;
- Obtain written approval before disposing or injecting salt water.

Mail to: KCC - Conservation Division, 130 S. Market - Room 2078, Wichita, Kansas 67202.

**IN ALL CASES PLOT THE INTENDED WELL ON THE PLAT BELOW**

**PLAT OF ACREAGE ATTRIBUTABLE TO A WELL IN A PRORATED OR SPACED FIELD**

If the intended well is in a prorated or spaced field, please fully complete this side of the form. If the intended well is in a prorated or spaced field complete the plat below showing that the well will be properly located in relationship to other wells producing from the common source of supply. Please show all the wells within 1 mile of the boundaries of the proposed acreage attribution unit for gas wells and within 1/2 mile of the boundaries of the proposed acreage attribution unit for oil wells.

API NO. 15- \_\_\_\_\_  
 OPERATOR MAI OIL OPERATIONS, INC.  
 LEASE VINE  
 WELL NUMBER 7  
 FIELD SOLOMON

LOCATION OF WELL: COUNTY ELLIS  
990 feet from south/north line of section  
2310 feet from east/west line of section  
 SECTION 27 TWP 11 RG 19W



NUMBER OF ACRES ATTRIBUTABLE TO WELL \_\_\_\_\_  
 QTR/QTR/QTR OF ACREAGE \_\_\_\_\_

IS SECTION X REGULAR or \_\_\_\_\_ IRREGULAR  
IF SECTION IS IRREGULAR, LOCATE WELL FROM NEAREST CORNER BOUNDARY.

Section corner used: \_\_\_\_\_ NE \_\_\_\_\_ NW \_\_\_\_\_ SE \_\_\_\_\_ SW

**PLAT**

(Show location of the well and shade attributable acreage for prorated or spaced wells.)  
 (Show footage to the nearest lease or unit boundary line.)

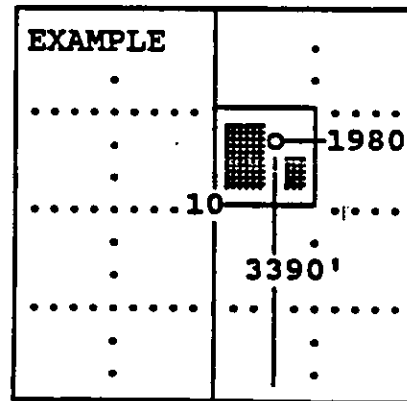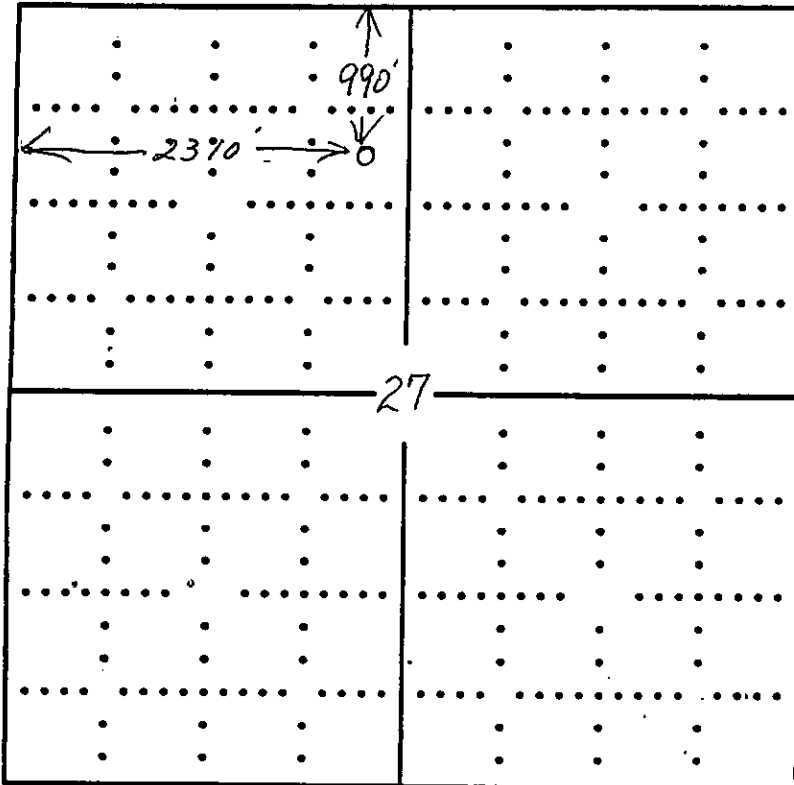

SEWARD CO.

**In plotting the proposed location of the well, you must show:**

- ) The manner in which you are using the depicted plat by identifying section lines, i.e. 1 section, 1 section with 8 surrounding sections, 4 sections, etc.;
- ) the distance of the proposed drilling location from the section's south/north and east/west; and
- ) the distance to the nearest lease or unit boundary line.