

NOTICE OF INTENTION TO DRILL

(see rules on reverse side)

Expected Spud Date. 8 10 88 month day year

API Number 15-135-23,280-00-00

OPERATOR: License # 3567
Name Totten Resources, Inc.
Address 2506 Greenleaf Court
City/State/Zip Wichita, Kansas 67226
Contact Person Matt Totten
Phone 316-687-4959

S 1/2 N 1/2 SE Sec. 17 Twp. 18 S, Rg 25
1650 Ft. from South Line of Section
1320 Ft. from East Line of Section

(Note: Locate well on Section Plat on reverse side)

CONTRACTOR: License # 4083
Name Western Kansas Drilling, Inc.
City/State Hays, Kansas 67601

Nearest lease or unit boundary line 1320 feet
County Ness
Lease Name Finnup Well # 1
Ground surface elevation 2500 feet MSL

Well Drilled For: Well Class: Type Equipment:
X Oil Storage Infield X Mud Rotary
Gas Inj Pool Ext Air Rotary
OWWO Expl X Wildcat Cable

Domestic well within 330 feet: yes X no
Municipal well within one mile: yes X no
Depth to bottom of fresh water 100'
Depth to bottom of usable water 975'

If OWWO: old well info as follows:

Surface pipe by Alternate: 1 2 X
Surface pipe planned to be set 200+
Conductor pipe required
Projected Total Depth 4500 feet
Formation Mississippian

Operator
Well Name
Comp Date Old Total Depth

I certify that well will comply with K.S.A. 55-101, et seq., plus eventually plugging hole to KCC specifications.

Date Signature of Operator or Agent Title 8-8-88

For KCC Use:

Conductor Pipe Required feet; Minimum Surface Pipe Required 200' feet per Alt. X (2)
This Authorization Expires 2-10-89 Approved By EKM 8-10-88


EFFECTIVE DATE 8-15-88

Must be filed with the K.C.C. five (5) days prior to commencing well
This card void if drilling not started within six (6) months of date received by K.C.C.

Important procedures to follow:

1. Notify District office before setting surface casing.
2. Set surface casing by circulating cement to the top.
3. File completion forms ACO-1 with K.C.C. within 120 days of well spud date, following instructions on ACO-1, side 1, and including copies of wireline logs.
4. Notify District office 48 hours prior to old well workover or re-entry.
5. Prior to filing Intent, prepare a proposed plugging plan in case well is plugged & a plan to obtain approval of plan when calling district office prior to setting surface pipe.
6. Submit plugging report (CP-4) to K.C.C. after plugging is completed.
7. Obtain an approved injection docket number before disposing of salt water.
8. Notify K.C.C. within 10 days when injection commences or terminates.
9. If an alternate 2 completion, cement in the production pipe from below any usable water to surface within 120 days of spud date.

A Regular Section of Land 1 Mile = 5,280 Ft.

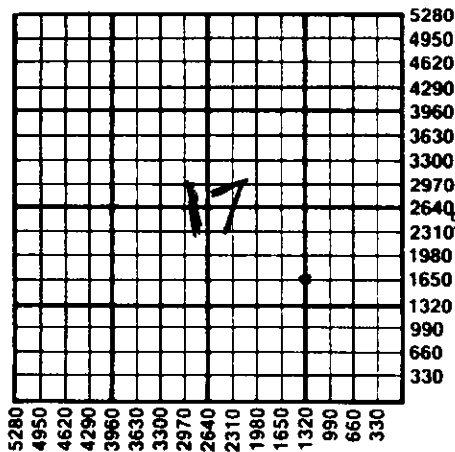

RECEIVED
STATE CORPORATION COMMISSION

AUG 10 1988

CONSERVATION DIVISION
Wichita, Kansas

08-10-1988

State Corporation Commission of Kansas
Conservation Division
200 Colorado Derby Building
Wichita, Kansas 67202-1212
(316) 263-3238