

CARD MUST BE TYPED

State of Kansas
NOTICE OF INTENTION TO DRILL

CARD MUST BE SIGNED

(see rules on reverse side)

Starting Date: October 9, 1984
month day year

API Number 15- 135-22,693-00-00

OPERATOR: License # 9289
Name: Walter Oil & Gas Corporation
Address: 240 Main Bldg., 1212 Main St.
City/State/Zip: Houston, Texas 77002
Contact Person: Kim Burkett
Phone: 713/659-1221

NE NW NE Sec 10 Twp 18 S. Rge 25
(location) East West

4950 Ft North from Southeast Corner of Section
1520 Ft West from Southeast Corner of Section
(Note: Locate well on Section Plat on reverse side)

CONTRACTOR: License # 5142
Name: Sterling Drilling Company
City/State: Sterling, Kansas 67579

Nearest lease or unit boundary line 330 feet.
County Ness

Lease Name Moses Estate "A" Well# 1

Domestic well within 330 feet: yes no
Municipal well within one mile: yes no

Well Drilled For: Well Class: Type Equipment:
 Oil Swd Infield Mud Rotary
 Gas Inj Pool Est Air Rotary
 OWWO Expl Wildcat Cable

Depth to Bottom of fresh water 90 feet
Lowest usable water formation Dakota
Depth to Bottom of usable water 675 feet

If OWWO: old well info as follows:

Operator
Well Name
Comp Date Old Total Depth
Projected Total Depth 4400 feet
Projected Formation at TD Mississippi
Expected Producing Formations Mississippi

Surface pipe by Alternate: 1 2
Surface pipe to be set 280' feet
Conductor pipe if any required None feet
Ground surface elevation 2360 feet MSL

This Authorization Expires 4-25
Approved By 10-5-84 R

I certify that we will comply with K.S.A. 55-101, et seq., plus eventually plugging hole to K.C.C. specifications.

Date 10/4/84 Signature of Operator or Agent

Kim Burkett Title Engineering Assistant
Kim Burkett


MHC/NOHE 10/5/84 Form C-1 4/84

Must be filed with the K.C.C. five (5) days prior to commencing well
 This permit is void if drilling not started within six (6) months of date received by K.C.C.

186 S 100 10-05-1984

STATE CORPORATION COMMISSION

A Regular Section of Land
 1 Mile = 5,280 Ft.

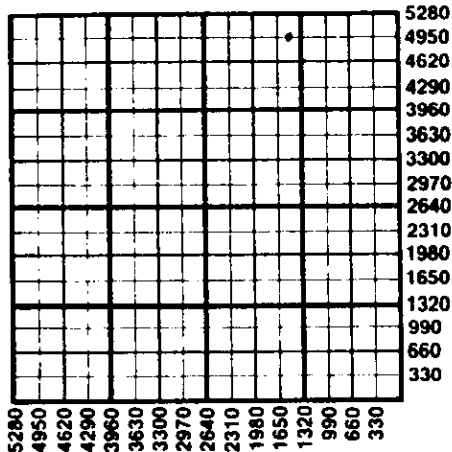

Important procedures to follow :

1. Notify District office before setting surface casing.
2. Set surface casing by circulating cement to the top.
3. File completion forms ACO-1 with K.C.C. within 90 days of well completion, following instructions on ACO-1, side 1, and including copies of wireline logs.
4. Notify District office 48 hours prior to old well workover or re-entry.
5. Prior to plugging, prepare a plugging plan, then obtain agreement from the appropriate district office for an approved plugging plan.
6. Submit plugging report (CP-4) to K.C.C. after plugging is completed.
7. Obtain an approved injection docket number before disposing of salt water.
8. Notify K.C.C. within 10 days when injection commences or terminates.
9. If an alternate 2 completion, cement in the production pipe from below any usable water to surface within 120 days of spud date.

State Corporation Commission of Kansas
 Conservation Division
 200 Colorado Derby Building
 Wichita, Kansas 67202
 (316) 263-3238