


STATE OF KANSAS
STATE CORPORATION COMMISSION

WELL PLUGGING RECORD

Give All Information Completely
Make Required Affidavit
Mail or Deliver Report to
Conservation Division
State Corporation Comm.
245 North Water
Wichita, KS 67202

Ness County, Sec. 6 Twp. 18 Rge. 22 E/W
Location as "NE/CNW¹/SW⁴" or footage from lines
W/2 SW/4

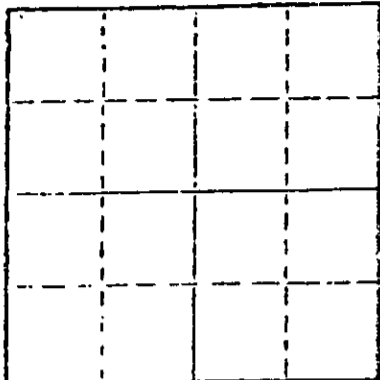

Locate well correctly on above
Section Plot

Lease Owner Twin Western Resources, Inc.
Lease Name Seib Well No. 1
Office Address 922 Union Center Building, Wichita 67202
Character of Well (Completed as Oil, Gas or Dry Hole) Dry Hole
Date Well completed 3/21/80 19
Application for plugging filed 3/21/80 19
Application for plugging approved 3/21/80 19
Plugging commenced 3/21/80 19
Plugging completed 3/21/80 19
Reason for abandonment of well or producing formation _____

If a producing well is abandoned, date of last production _____ 19

Was permission obtained from the Conservation Division or its agents before plugging was commenced? Yes

Name of Conservation Agent who supervised plugging of this well Marion Schmidt
Producing formation _____ Depth to top _____ Bottom _____ Total Depth of Well _____
Show depth and thickness of all water, oil and gas formations. RTD 4360'

OIL, GAS OR WATER RECORDS

CASING RECORD

FORMATION	CONTENT	FROM	TO	SIZE -	PUT IN	PULLED OUT
	Surface	0	493	8-5/8"	yes	no

Describe in detail the manner in which the well was plugged, indicating where the mud fluid was placed and the method or methods used in introducing it into the hold. If cement or other plugs were used, state the character of same and depth placed, from _____ feet to _____ feet for each plug set.

1st plug @ 740' with 70 sacks

2nd plug @ 400' with 20 sacks

3rd plug @ 40' with 10 sacks

5 sacks in rathole

Job complete @ 11:30 p.m. 3/21/80

04-03-1980
APR - 3 1980

(If additional description is necessary, use BACK of this sheet)

Name of Plugging Contractor Slawson Drilling Company, Inc.

STATE OF Kansas COUNTY OF Sedgwick, ss.
James C. Remsberg, Slawson Drilling Co., Inc. (employee of owner) or (owner or operator of the above-described well, being first duly sworn on oath, says: That I have knowledge of the facts, statements, and matters herein contained and the log of the above-described well as filed and that the same are true and correct. So help me God.

(Signature)

James C. Remsberg
James C. Remsberg
200 Douglas Building, Wichita 67202
(Address)

SUBSCRIBED AND SWORN TO before me this 1st day of April, 1980

Mary Lou Taylor
Mary Lou Taylor Notary Public.

My commission expires January 17, 1981



DRILLERS LOG

OPERATOR: Twin-Western Resources, Inc.
 922 Union Center Building
 Wichita, Kansas 67202

LEASE: Seib #1
 W/2 SW/4 Sec. 6-18S-22W
 Ness County, Kansas

CONTRACTOR: Slawson Drilling Company, Inc.
 200 Douglas Building
 Wichita, Kansas 67202

COMMENCED: 3/11/80

COMPLETED: 3/21/80

RTD: 4360'

SURFACE CASING: 8-5/8" set at 493' with 300 sx cement

0' to 500' 12½" Surface Hole
 500' to 3000' Shale
 3000' to 3710' Shale & Lime
 3710' to 3867' Lime & Shale
 3867' to 4160' Shale & Lime
 4160' to 4295' Lime
 4295' to 4360' Mississippian
 4360' RTD

RECORDED
 04-03-1980

STATE OF KANSAS

COUNTY OF SEDGWICK

I, James C. Remsberg, of the Slawson Drilling Company, Inc.
 hereby state the above and foregoing is an accurate copy of the Sieb #1
 log for Twin-Western Resources, Inc.

James C. Remsberg
 James C. Remsberg

Subscribed and sworn to me
 this 1st day of April, 1980

Mary Lou Taylor
 Mary Lou Taylor, Notary

My commission expires January 17, 1981

