


Give All Information Completely
Make Required Affidavit
Mail or Deliver Report to:
Conservation Division
State Corporation Commission
211 No. Broadway
Wichita, Kansas

15-135-00345-00-00

Form CP-4

WELL PLUGGING RECORD

NORTH

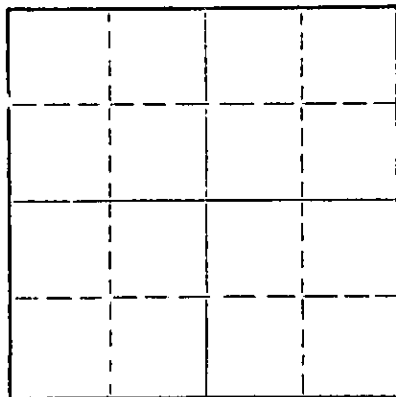

Locate well correctly on above
Section Plat

Ness County. Sec. 5 Twp. 18S Rge. 22W (E) (W)
Location as "NE/CNW/SW" or footage from lines C NW NW
Lease Owner Imperial Oil Company
Lease Name EIMORE Well No. 1
Office Address 780 Fourth National Bldg., Wichita, Ks.
Character of Well (completed as Oil, Gas or Dry Hole) Dry Hole
Date well completed 7-12-64 19
Application for plugging filed 7-12-64 19
Application for plugging approved 7-12-64 19
Plugging commenced 7-12-64 19
Plugging completed 7-12-64 19
Reason for abandonment of well or producing formation No commercial
quantities of oil found.
If a producing well is abandoned, date of last production --- 19
Was permission obtained from the Conservation Division or its agents before plugging was com-
menced? Yes

Name of Conservation Agent who supervised plugging of this well Eldon Petty
Producing formation -- Depth to top. Bottom Total Depth of Well 4320 Feet
Show depth and thickness of all water, oil and gas formations.

OIL, GAS OR WATER RECORDS

CASING RECORD

FORMATION	CONTENT	FROM	TO	SIZE	PUT IN	PULLED OUT
	Surface Casing:		XXXXX	8-5/8"	273'	Not pulled

Describe in detail the manner in which the well was plugged, indicating where the mud fluid was placed and the method or methods used
in introducing it into the hole. If cement or other plugs were used, state the character of same and depth placed, from feet to
feet for each plug set.

Set first plug at 600 ft. with 20 sacks cement;
Set second plug at 240 ft. with 10 sacks cement;
Set third plug at 40 ft. with 10 sacks.

RECEIVED
STATE CORPORATION COMMISSION

JUL 27 1964
07-27-1964
CONSERVATION DIVISION
Wichita, Kansas

(If additional description is necessary, use BACK of this sheet)

Name of Plugging Contractor Imperial Oil of Kansas, Inc.
Address Box 784, Great Bend, Kansas

STATE OF KANSAS COUNTY OF SEDGWICK ss.
Raymond R. Dombaugh (employee of owner) or (owner or operator) of the above-described
well, being first duly sworn on oath, says: That I have knowledge of the facts, statements, and matters herein contained and the log of the
above-described well as filed and that the same are true and correct. So help me God.

(Signature) Raymond R. Dombaugh
780 Fourth National Bldg., Wichita, Ks.
(Address)

SUBSCRIBED AND SWORN TO before me this 23rd day of July, 1964

My commission expires July 5, 1966

Bette J. Silcott
Bette J. Silcott Notary Public.

15-135-00345-00-00

DRILLER'S LOG

Imperial Oil Company
780 Fourth National Building
Wichita, Kansas

ELMORE NO. 1
C NW NW, Sec. 5-18S-22W
Ness County, Kansas

RECEIVED
STATE CORPORATION COMMISSION

JUL 27 1964

07-27-1964
CONSERVATION DIVISION
Wichita, Kansas

Total Depth: 4320 ft.

Elevation: 2255 KB

Commenced: 6-29-64

Contractor: Imperial Oil of Kansas, Inc.
Rig #2

Casing record: Set 273 ft. of 8-5/8" surface pipe. Cemented with 225 sacks cement.

Figures indicate bottom of formations:

		TOPS	
Surface, Sand & Shale	830'	Anhydrite	--
Shale	930'	Heebner	3654 (-1399)
Elaine	938'	Toronto	3681 (-1426)
Sand & Shale	1455'	Lansing	3697 (-1442)
Shale & Shells	1502'	Ft. Scott	4082 (-1827)
Anhydrite	1539'	Cherokee Shale	4172 (-1917)
Shale	1550'	Mississippi Warsaw	4258 (-2003)
Shale	2285'	Mississippi Osage	4280 (-2025)
Shale - Lime	3760'		
Lime	4298'	Rotary Total Depth:	4320 (-2065)
Chert	4320'		

We hereby certify this to be a correct and accurate log for the above described well, as shown on the daily drilling reports.

IMPERIAL OIL COMPANY

By Edmond K. Womack

Subscribed and sworn to before me this 23rd day of July, 1964.

My commission expires: July 5, 1966

Bette J. Silcott
Bette J. Silcott, Notary Public