


STATE OF KANSAS  
STATE CORPORATION COMMISSION

15-135-00317-00-00

WELL PLUGGING RECORD

Give All Information Completely  
Make Required Affidavit  
Mail or Deliver Report to:  
Conservation Division  
State Corporation Commission  
800 Bitting Building  
Wichita, Kansas

Ness County, Sec. 33 Twp. 18S Rge. 22E (E) (W)  
Location as "NE/CNW/SW" or footage from lines C NW SE  
Lease Owner Full Drilling Co. Inc.  
Lease Name Grusing Well No. 1  
Office Address 1625 Plaza Bldg. Wichita, Kansas  
Character of Well (completed as Oil, Gas or Dry Hole) Dry Hole  
Date well completed 1-18-64 19  
Application for plugging filed 1-18-64 19  
Application for plugging approved 1-18-64 19  
Plugging commenced 1-18-64 19  
Plugging completed 1-18-64 19  
Reason for abandonment of well or producing formation Non productive.

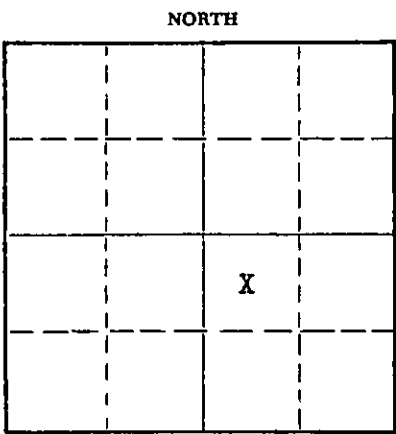

Locate well correctly on above Section Plat

If a producing well is abandoned, date of last production 19  
Was permission obtained from the Conservation Division or its agents before plugging was commenced? Mr. Petty Hays, Kansas

Name of Conservation Agent who supervised plugging of this well  
Producing formation Depth to top Bottom Total Depth of Well ~~4350~~ 4350 Feet  
Show depth and thickness of all water, oil and gas formations.

OIL, GAS OR WATER RECORDS

CASING RECORD

FORMATION	CONTENT	FROM	TO	SIZE	PUT IN	PULLED OUT

Describe in detail the manner in which the well was plugged, indicating where the mud fluid was placed and the method or methods used in introducing it into the hole. If cement or other plugs were used, state the character of same and depth placed, from feet to feet for each plug set.  
Hole plugged through drill pipe with a plug set at 500' and 20 sacks cement a plug set at 200' with 20 sacks cement and a plug set at 40' and 10 sacks cement.

**RECEIVED**  
STATE CORPORATION COMMISSION  
FEB 10 1964  
02-10-1964  
CONSERVATION DIVISION  
Wichita, Kansas

(If additional description is necessary, use BACK of this sheet)  
Name of Plugging Contractor Co. tools and Globe Cementing Co.  
Address 1625 Plaza Bldg. Wichita, Kansas

STATE OF KANSAS, COUNTY OF SEDGWICK, ss.  
Joseph O. Butts (employee of owner) or (owner or operator) of the above-described well, being first duly sworn on oath, says: That I have knowledge of the facts, statements, and matters herein contained and the log of the above-described well as filed and that the same are true and correct. So help me God.

(Signature) Joseph O. Butts  
Wichita, Kansas  
(Address)

SUBSCRIBED AND SWORN TO before me this 6th day of February, 1964

My commission expires October 16, 1965  
Bettie H. Salter  
Bettie H. Salter Notary Public.

R O T A R Y D R I L L E R ' S

L O G

15-135-00317-0000

COMPANY: Mull Drilling Co., Inc.  
Wichita, Kansas

ROTARY DRILLING COMMENCED:  
1-9-64

CONTRACTOR: Mull Drilling Co., Inc.  
Wichita, Kansas

ROTARY DRILLING COMPLETED:  
1-18-64

CASING RECORD: Set 242' B 5/8" Surf.Csg.  
w/165 Sx.

LOCATION: Grusing #1  
C NW SE 33-18S-22W  
Ness County, Kansas

(Figures indicate bottom of formation; measurements from top of Rotary Bushing.)

110'	Clay, Etc.
264'	Blue Shale
510'	Sand
1474'	Blue Shale w/Sand
1510'	Anhydrite Lime
2225'	Shale
3280'	Lime w/Shale
3492'	Sandy Lime & Shale
3717'	Lime w/Shale
3860'	Lime
4314'	Cherty Lime w/Shale
4350'	Mississippi and Total Depth

I hereby certify that this is a true and correct copy of the above  
log to the best of my knowledge.  
Log to be

MULL DRILLING COMPANY, INC.

*Joseph B. Brungardt, Jr.*  
Joseph B. Brungardt, Jr.

STATE OF KANSAS )  
                          )  
                          )  
COUNTY OF SEDGWICK )

Subscribed and sworn before me this 30th day of  
January, 1964.

*Lola L. Foster*  
Lola L. Foster, Notary Public

My commission expires April 17, 1966.



RECEIVED  
STATE CORPORATION COMMISSION

FEB 10 1964  
02-10-1964  
CONSERVATION DIVISION  
Wichita, Kansas