
15-135-00216-00-00

STATE OF KANSAS
STATE CORPORATION COMMISSION

Give All Information Completely
Make Required Affidavit
Mail or Deliver Report to:
Conservation Division
State Corporation Commission
212 North Market, Insurance Bldg.
Wichita, Kansas

WELL PLUGGING RECORD

NORTH

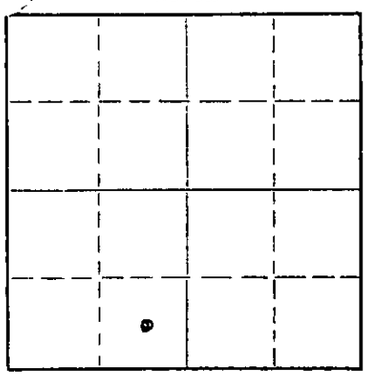

Locate well correctly on above Section Plat

Ness County. Sec. 29 Twp. 18S Rge. 22 (E) W (W)

Location as "NE/CNW¼SW¼" or footage from lines C SE SW

Lease Owner Socony Mobil Oil Company, Inc.

Lease Name Elsasser Heirs Well No. 1

Office Address 300 North Broadway, Wichita, Kansas - 67202

Character of Well (completed as Oil, Gas or Dry Hole) Dry Hole

Date well completed 19

Application for plugging filed 1-5-64 19

Application for plugging approved 1-5-64 19

Plugging commenced 1-5-64 19

Plugging completed 1-5-64 19

Reason for abandonment of well or producing formation Drilled dry

If a producing well is abandoned, date of last production 19

Was permission obtained from the Conservation Division or its agents before plugging was commenced? Yes

Name of Conservation Agent who supervised plugging of this well Eldon Petty

Producing formation Depth to top Bottom Total Depth of Well 4496 Feet

Show depth and thickness of all water, oil and gas formations.

OIL, GAS OR WATER RECORDS — CASING RECORD

FORMATION	CONTENT	FROM	TO	SIZE	PUT IN	PULLED OUT
				8-5/8"	304'	0

Describe in detail the manner in which the well was plugged, indicating where the mud fluid was placed and the method or methods used in introducing it into the hole. If cement or other plugs were used, state the character of same and depth placed, from feet to feet for each plug set.

Set cement plug at 600' thru drill pipe w/20 sx cement. Set cement plug at 240' thru drill pipe w/1/2 sx hulls and 20 sx cement. Filled to surface.

(If additional description is necessary, use BACK of this sheet)

Name of Plugging Contractor Red Tiger Drilling Co.

Address Box 173, Russell, Kansas

STATE OF Kansas, COUNTY OF Sedgwick, ss.

T. V. Herriage (employee of owner) of ~~(owner or operator)~~ of the above-described well, being first duly sworn on oath, says: That I have knowledge of the facts, statements, and matters herein contained and the log of the above-described well as filed and that the same are true and correct. So help me God.

(Signature) T. V. Herriage Office Group Supvr.

300 North Broadway, Wichita, Kansas - 67202
(Address)

SUBSCRIBED AND SWORN TO before me this 13 day of January 19 64

Jack Beard Notary Public.

My commission expires 4-4-66

RECEIVED
STATE CORPORATION COMMISSION
JAN 17 1964
01-17-1964
CONSERVATION DIVISION
Wichita, Kansas

5-44M

Mobile Oil Co

DRILLERS LOG

Elsasser-Heirs #1 15-135-00316-00-00

CASING RECORD: 8 5/8" @ 217' w/175 sx cement

TOTAL DEPTH: 4496'

COMPANY: Mobil Oil Company

CONTRACTOR: Red Tiger Drilling

COMMENCED: December 19, 1963

COMPLETED: January 5, 1964

DESCRIPTION: C SE SW 29-18S-22W Ness Co., Kansas

ELEVATION: 2302 DF 2300 KB

FORMATION	FROM	TO	REMARKS
Surface Soil & Clay	0	40	
Surface Clay & Shale	40	1400	
Redbed & Shale	1400	1507	
Lime	1507	1585	
Shale & Shells	1585	1620	
Shale Sand & Pyrite	1620	1640	
Shale & Shells	1640	2140	
Shale & Lime Shells	2140	2295	
Lime & Shale	2295	2900	
Lime	2900	2985	
Lime Shaly & Chert	2985	4092	
Lime & Shale	4092	4150	
Lime	4150	4190	
Lime Shale & Chert	4190	4231	
Lime & Shale	4231	4295	
Mississippi	4295	4340	
Chert Shale & Lime	4340	4351	
Mississippi & Chert	4351	4496	

RECEIVED
STATE CORPORATION COMMISSION
FEB 20 1964
02-20-1964
CONSERVATION DIVISION
Wichita, Kansas

I certify that this is a true and correct copy of the above log to the best of my knowledge.

RED TIGER DRILLING COMPANY

George A. Angle

Subscribed and sworn to before me this 6th day of January, 1964.

Notary Public

My Commission Expires:

8-11-66