


Give All Information Completely  
Make Required Affidavit  
Mail or Deliver Report to:  
Conservation Division  
State Corporation Commission  
211 No. Broadway  
Wichita, Kansas

WELL PLUGGING RECORD

Ness County. Sec. 23 Twp. 18 Rge. 20 (E) W (W)

Location as "NE/CNW/SW" or footage from lines NE NE  
Lease Owner L. J. Dreiling & Sons, Inc.  
Lease Name Schultz Well No. 1  
Office Address Victoria, Kansas  
Character of Well (completed as Oil, Gas or Dry Hole) Dry  
Date well completed 4-21-1966  
Application for plugging filed 4-21-1966  
Application for plugging approved 4-21-1966  
Plugging commenced 4-21-1966  
Plugging completed 4-21-1966  
Reason for abandonment of well or producing formation Dry

NORTH

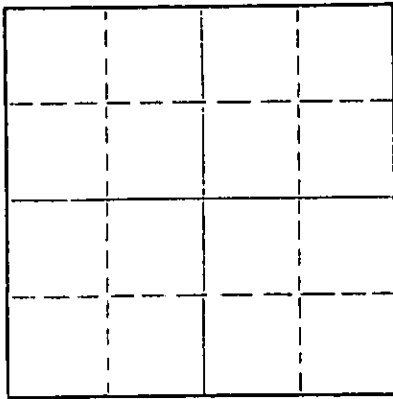

Locate well correctly on above  
Section Plat

If a producing well is abandoned, date of last production 19  
Was permission obtained from the Conservation Division or its agents before plugging was commenced? yes

Name of Conservation Agent who supervised plugging of this well Mr. Leo Massey--Hays, Kansas  
Producing formation Depth to top Bottom Total Depth of Well 4303' Feet  
Show depth and thickness of all water, oil and gas formations.

OIL, GAS OR WATER RECORDS

CASING RECORD

FORMATION	CONTENT	FROM	TO	SIZE	PUT IN	PULLED OUT
SURFACE PIPE				8-5/8"	8-5/8" 290'	

Describe in detail the manner in which the well was plugged, indicating where the mud fluid was placed and the method or methods used in introducing it into the hole. If cement or other plugs were used, state the character of same and depth placed, from feet to feet for each plug set.

Filled hole with rotary mud to a depth of 540' where 1st plug was set using 20 sacks cement. Filling hole with rotary mud to a depth of 280' where 2nd plug was set using 20 sacks cement. Rotary mud was used to fill hole to a depth of 40' where 3rd plug was set using 10 sacks cement & 1/2 Halls and filling hole to surface.

RECEIVED  
STATE CORPORATION COMMISSION

APR 28 1966

04-28-1966  
CONSERVATION DIVISION  
Wichita, Kansas

(If additional description is necessary, use BACK of this sheet)

Name of Plugging Contractor L. J. Dreiling & Sons, Inc.  
Address Route # 2 Victoria, Kansas

STATE OF Kansas, COUNTY OF Ellis, ss.  
I, Leo F. Dreiling, a partner

(Signature of owner or operator or person in charge of the above-described well, being first duly sworn on oath, says: That I have knowledge of the facts, statements, and matters herein contained and the log of the above-described well as filed and that the same are true and correct. So help me God.

(Signature) Leo F. Dreiling

LEO F. DREILING Victoria, Kansas  
(Address)

SUBSCRIBED AND SWORN TO before me this 21st day of April, 1966

My commission expires October 26, 1968

ELMER WELTZ

Notary Public.

15-135-30199-00-00

L. J. DREILING and SONS, Inc.  
VICTORIA, KANSAS

WELL LOG

Company L. J. Dreiling & Sons, Inc.  
Victoria, Kansas

Sec. 23 Twp. 18 Rng. 20

Farm Schultz No. # 1

Location NE NE

Total Depth 4303'

County Ness

Comm. 4-13-66

Comp. 4-21-66

Elevation: D. F. 2181'  
K. B. 2184'  
G. R. 2179'

Contractor L. J. Dreiling & Sons, Inc.  
Victoria, Kansas  
Casing Record

Cement Record

Production:

290' 8-5/8"

175 sax

D & A

Figures Indicate Bottom of Formations

0'	30'	Surface Soil & Clay
30'	45'	Sand
45'	130'	Shale
130'	150'	Sand & Shale
150'	280'	Shale
280'	290'	Shale
290'	700'	Shale
700'	896'	Red Bed
896'	1135'	Sand
1135'	1450'	Red Bed
1450'	1461'	Red Bed
1461'	1495'	Anhy
1495'	1500'	Anhy
1500'	1510'	Anhy
1510'	1875'	Shale & Shells
1875'	2155'	Shale & Shells
2155'	2331'	Shale & Lime
2331'	2500'	Lime & Shale
2500'	2693'	Lime & Shale
2693'	2943'	Shale & Lime
2943'	3160'	Shale & Lime
3160'	3455'	Shale & Lime
3455'	3665'	Shale & Lime
3665'	3790'	Lime & Shale
3790'	3890'	Lime
3890'	3950'	Lime
3950'	4035'	Lime
4035'	4092'	Lime
4092'	4141'	Lime
4141'	4210'	Lime
4210'	4282'	Lime
4282'	4290'	Lime
4290'	4303'	Lime
4303'	T.D.	

RECEIVED  
STATE DEPARTMENT COMMISSION  
APR 28 1966  
CONSERVATION DIVISION  
Wichita, Kansas

04-28-1966

STATE OF KANSAS)

COUNTY OF BLAKE)

I, Lee F. Dreiling, of the L. J. Dreiling & Sons, upon oath states that the above and foregoing is a true and correct copy from the Daily Drilling Report from your Schultz # 1.

*Lee F. Dreiling*  
LEE F. DREILING

Subscribed and sworn to before me this 21st day of April, 1966.

*Elmer Zick*  
NOTARY PUBLIC

My Commission expires: October 26, 1968