


WELL PLUGGING RECORD

All Information Completely
Make Required Affidavit
Mail or Deliver Report to:
Conservation Division
State Corporation Commission
212 No. Market
Wichita, Kansas

NORTH

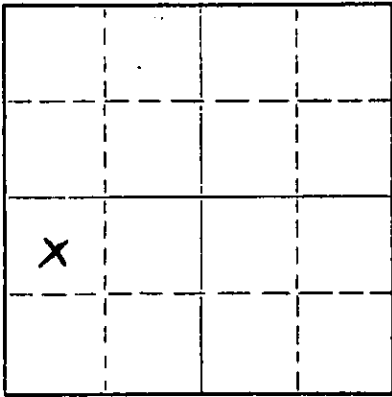

Locate well correctly on above
Section Plat

Ness County. Sec 22 Twp. 18S Rge. 22 (E) W (W)
Location as "NE/CNWxSWx" or footage from lines G NW SW
Lease Owner Pickrell Drlg. Co. Wichita, Kans. 67202
Lease Name Wegele "A" Well No. #1
Office Address 705 Fourth National Bank Building
Character of Well (completed as Oil, Gas or Dry Hole) Oil Well
Date well completed March 22 1968
Application for plugging filed December 1 1969
Application for plugging approved December 1 1969
Plugging commenced November 26 1969
Plugging completed December 1 1969
Reason for abandonment of well or producing formation Depleted

If a producing well is abandoned, date of last production May 31 1969
Was permission obtained from the Conservation Division or its agents before plugging was commenced? Yes

Name of Conservation Agent who supervised plugging of this well Leo Massey
Producing formation Cherokee Sand Depth to top 4237 Bottom 4247 Total Depth of Well 4332 Feet
Show depth and thickness of all water, oil and gas formations.

OIL, GAS OR WATER RECORDS

CASING RECORD

FORMATION	CONTENT	FROM	TO	SIZE	PUT IN	PULLED OUT
				8-5/8"	255	None
				5-1/2"	4319	2329

Describe in detail the manner in which the well was plugged, indicating where the mud fluid was placed and the method or methods used in introducing it into the hole. If cement or other plugs were used, state the character of same and depth placed, from _____ feet to _____ feet for each plug set.

November 26, 1969 Dumped sand to 4200'. Mixed and dumped 5 sx of cement to 4160'.

December 1, 1969 Mixed and pumped down 8-5/8" casing 16 sx of gel and 3 sx of hulls, 80 sx of cement and 4 sx of gel. Released plug and mixed and pumped 20 sx of cement.


RECEIVED
STATE CORPORATION COMMISSION
JAN 19 1970
CONSERVATION DIVISION
Wichita, Kansas

(If additional description is necessary, use BACK of this sheet)
Name of Plugging Contractor RUSS CASING PULLING, INC.
Address P. O. BOX 1082 GREAT BEND, KANSAS 67530

STATE OF Kansas COUNTY OF Sedgwick ss.
Dale M. Robinson (employee of owner) or (owner or operator) of the above-described well, being first duly sworn on oath, says: That I have knowledge of the facts, statements, and matters herein contained and the log of the above-described well as filed and that the same are true and correct. So help me God.

(Signature) Dale M. Robinson
705 Fourth National Bank Bldg., Wichita, Kansas
(Address)

Subscribed and sworn to before me this 16th day of January, 1970.

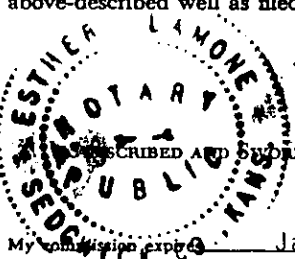

January 19, 1973
Esther Lamone Notary Public.

ROTARY DRILLING LOG

15-35-20127-00-00

COMPANY: Pickrell Drilling Company
705 4th National Bank Bldg.
Wichita, Kansas

Rotary Drilling Commenced 3/5/68
Rotary Drilling Completed 3/15/68

LOCATION: Wegele "A" No. 1, C NW SW Section 22-18S-22W, Ness County, Kansas.

CONTRACTOR: **PICKRELL DRILLING COMPANY**
Wichita, Kansas

CASING RECORD: (12 jts) 255' of 8 5/8" surface casing set with 165 sacks cement.
Circulated. (137 jts) 5 1/2" casing set @ 4318' w/80 sacks cement.
Completed 9:30 PM March 15, 1968.

LOG

(Figures indicate bottom of formation — measurements from top of rotary bushing.)

38	Clay	<u>C. F. S.</u>
159	Post Rock & Shale	4170
890	Shale & Shells	4183
1125	Sand	4250
1464	Shale & Shells	4265
1495	Anhydrite	4273
1850	Shale & Shells	4288
2100	Shale	4332
3875	Lime & Shale	
4085	Lime	
4265	Lime & Shale	<u>Slope Tests</u>
4332	Mississippian - TD	2500
		3000
		3500
		4000
		<u>S. L. M.</u>
		4183

RECEIVED
STATE CORPORATION COMMISSION
DEC 1 1969
CONSERVATION DIVISION
Wichita, Kansas
12-01-1969

The undersigned, C. W. SEBITS, Attorney-in-Fact for PICKRELL DRILLING COMPANY, hereby certifies in behalf of said Company, that the above is a true and correct log of the formation encountered in drilling the above well as reflected by the Daily Drilling Reports.

PICKRELL DRILLING COMPANY

By [Signature]
C. W. SEBITS Attorney-in-Fact

STATE OF KANSAS }
COUNTY OF SEDGWICK } ss.:

On this 25 day of March, 1968, before me the undersigned, a Notary Public, in and for the County and State aforesaid, personally appeared C. W. SEBITS, to me known to be the identical person who subscribed the name of PICKRELL DRILLING COMPANY to the foregoing instrument as its Attorney-in-Fact and acknowledged to me that he executed the same as his free and voluntary act and deed, and as the free and voluntary act and deed of such company, for the uses and purposes therein set forth.

Given under my hand and seal of office the day and year last above written.

My commission expires: May 10, 1970

[Signature]
L. M. WHITING Notary Public