

NOTICE OF INTENTION TO DRILL

(see rules on reverse side)

Expected Spud Date..... September 8, 1988  
 month day year

API Number 15-135-23,237-A-00-01

OPERATOR: License #..... 3567  
 Name..... TOTTEN RESOURCES, INC.  
 Address..... 2506 Green Leaf Court  
 City/State/Zip..... Wichita, Kansas 67226  
 Contact Person..... Matt Totten  
 Phone..... 316/687-4959

w/2  
 SW.. SW.. Sec. 20... Twp. 17... S. Rg. 21...  East  
 West  
 990 6660 Ft. from South Line of Section  
 4290 4950 Ft. from East Line of Section

(Note: Locate well on Section Plat on reverse side)

CONTRACTOR: License #..... 5864  
 Name..... LOBO DRILLING COMPANY  
 City/State..... Great Bend, Kansas

Nearest lease or unit boundary line ..... 330 feet  
 County..... Ness  
 Lease Name..... Brenner Well # 1

Well Drilled For: Well Class: Type Equipment:  
 Oil  Storage  Infield  Mud Rotary  
 Gas  Inj  Pool Ext.  Air Rotary  
 OWWO  Expl  Wildcat  Cable

Ground surface elevation ..... feet MSL  
 Domestic well within 330 feet:  yes  no  
 Municipal well within one mile:  yes  no

If OWWO: old well info as follows:  
 Operator..... William N. Bucklin  
 Well Name..... Brenner #3  
 Comp Date..... 4/23/88 Old Total Depth..... 4335

Depth to bottom of fresh water..... 450  
 Depth to bottom of usable water..... 780  
 Surface pipe by Alternate: 1  2   
 Surface pipe planned to be set..... ~~XXXXXX~~ 257'  
 Conductor pipe required.....  
 Projected Total Depth..... 4335 feet  
 Formation..... Mississippi

I certify that well will comply with K.S.A. 55-101, et seq., plus eventually plugging hole to KCC specifications.

Date..... 9/7/88..... Signature of Operator or Agent..... Sally R. Byers Title..... Agent

For KCC Use:

Conductor Pipe Required ..... feet; Minimum Surface Pipe Required ..... 257' feet per Alt.  2

This Authorization Expires 3-7-89 Approved By LKM 9-7-88


EFFECTIVE DATE: 9-12-88

Must be filed with the K.C.C. five (5) days prior to commencing well  
This card void if drilling not started within six (6) months of date received by K.C.C.

**Important procedures to follow:**

1. Notify District office before setting surface casing.
2. Set surface casing by circulating cement to the top.
3. File completion forms ACO-1 with K.C.C. within 120 days of well spud date, following instructions on ACO-1, side 1, and including copies of wireline logs.
4. Notify District office 48 hours prior to old well workover or re-entry.
5. Prior to filing Intent, prepare a proposed plugging plan in case well is D & A, then obtain approval of plan when calling district office prior to setting surface pipe.
6. Submit plugging report (CP-4) to K.C.C. after plugging is completed.
7. Obtain an approved injection docket number before disposing of salt water.
8. Notify K.C.C. within 10 days when injection commences or terminates.
9. If an alternate 2 completion, cement in the production pipe from below any usable water to surface within 120 days of spud date.

**A Regular Section of Land**  
1 Mile = 5,280 Ft.

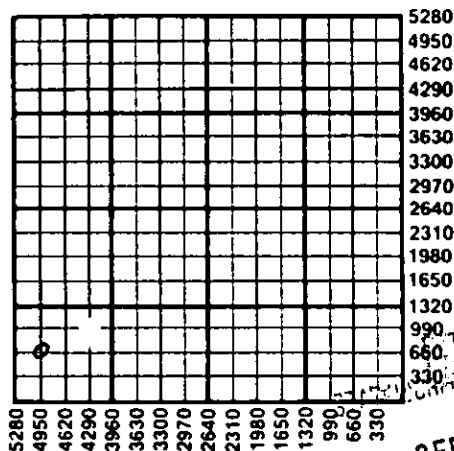

SEP 7 1988  
CONSERVATION DIVISION  
Wichita, Kansas  
09-07-1988

State Corporation Commission of Kansas  
Conservation Division  
200 Colorado Derby Building  
Wichita, Kansas 67202-1212  
(316) 263-3238