

CARD MUST BE TYPED

State of Kansas

CARD MUST BE SIGNED

NOTICE OF INTENTION TO DRILL

"Corrected Spot Loc." *✓*

(see rules on reverse side)

Expected Spud Date. 4 15 88
month day year

API Number 15— 135-23,237-~~00~~-00

OPERATOR: License # 6759
Name WILLIAM N. BUCKLIN, III
Address 150 California St., Ste. 300
City/State/Zip San Francisco, CA 94111
Contact Person William N. Bucklin, III
Phone 415-433-7100

* W/2 SW SW Sec. 20 Twp. 17 S. Rg. 21W — East
* 660 Ft. from South Line of Section
4950 Ft. from East Line of Section

(Note: Locate well on Section Plat on reverse side)

CONTRACTOR: License # 5302
Name Red Tiger Drilling Co.
City/State Wichita, KS 67202

* Nearest lease or unit boundary line 660 feet
County Ness
Lease Name Bremer Well # 3

Well Drilled For: Well Class: Type Equipment:
 Oil Storage Infield Mud Rotary
 Gas Inj Pool Ext. Air Rotary
 OWWO Expl Wildcat Cable

Ground surface elevation 200 feet MSL
Domestic well within 330 feet: —yes —no
Municipal well within one mile: —yes —no
Depth to bottom of fresh water 200
Depth to bottom of usable water 550
Surface pipe by Alternate: 1 2
Surface pipe planned to be set 250
Conductor pipe required N/A
Projected Total Depth 4400 feet
Formation Miss

If OWWO: old well info as follows:
Operator
Well Name
Comp Date Old Total Depth

I certify that well will comply with K.S.A. 55-101, et seq., plus eventually plumbing holes to KCC specifications.
Date 4-14-88 Signature of Operator or Agent *Henry A. [Signature]* Owner

For KCC Use:
Conductor Pipe Required _____ feet; Minimum Surface Pipe Required 200 feet per Alt. 2
This Authorization Expires 10-11-88 Approved By *[Signature]* 4-15-88 DRILL PERM. 04-11-88


EFFECTIVE DATE: 4-16-88 * WAS : 990' FSL, NW-SW-SW, NLL . 330'

Must be filed with the K.C.C. five (5) days prior to commencing well
This card void if drilling not started within six (6) months of date received by K.C.C.

Important procedures to follow:

1. Notify District office before setting surface casing.
2. Set surface casing by circulating cement to the top.
3. File completion forms ACO-1 with K.C.C. within 120 days of well spud date, following instructions on ACO-1, side 1, and including copies of wireline logs.
4. Notify District office 48 hours prior to old well workover or re-entry.
5. Prior to filing Intent, prepare a proposed plugging plan in case well is D & A, then obtain approval of plan when calling district office prior to setting surface pipe.
6. Submit plugging report (CP-4) to K.C.C. after plugging is completed.
7. Obtain an approved injection docket number before disposing of salt water.
8. Notify K.C.C. within 10 days when injection commences or terminates.
9. If an alternate 2 completion, cement in the production pipe from below any usable water to surface within 120 days of spud date.

A Regular Section of Land
1 Mile = 5,280 Ft.

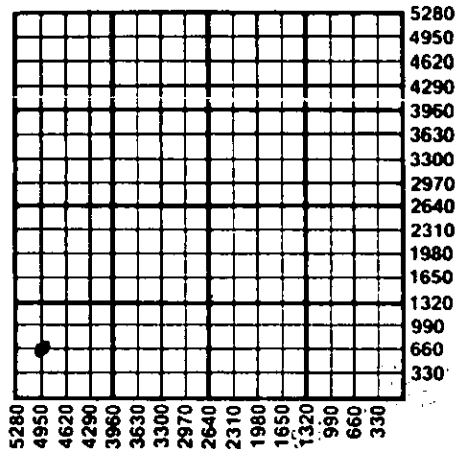

APR 15 1988
04-15-1988
CONSERVATION DIVISION
Wichita, Kansas

State Corporation Commission of Kansas
Conservation Division
200 Colorado Derby Building
Wichita, Kansas 67202-1212
(316) 263-3238