

CARD MUST BE TYPED

State of Kansas
NOTICE OF INTENTION TO DRILL

(see rules on reverse side)

CARD MUST BE SIGNED

051-21,128-#0001

Starting Date: July 25, 1985
month day year

API Number 15-~~051-21,128~~

OPERATOR: License # 5252

NE SW SE (location) Sec 3 Twp 13 S, Rge 16 East West

Name R. P. Nixon

Address 207 West 12th

City/State/Zip Hays, Kansas 67601

Contact Person Dan A Nixon

Phone 913 628 3834

990 Ft North from Southeast Corner of Section

1650 Ft West from Southeast Corner of Section

(Note: Locate well on Section Plat on reverse side)

CONTRACTOR: License # 5128

Nearest lease or unit boundary line 330 feet.

County Ellis

Lease Name Ottilia Well# 1

Domestic well within 330 feet: yes no

Municipal well within one mile: yes no

Name Jay-Lan Corp.

City/State Hays, Kansas 67601

Well Drilled For:	Well Class:	Type Equipment:
<input type="checkbox"/> Oil <input type="checkbox"/> Sew <input checked="" type="checkbox"/> Infield <input checked="" type="checkbox"/> Mud Rotary		
<input type="checkbox"/> Gas <input type="checkbox"/> Inj <input type="checkbox"/> Pool Ext. <input type="checkbox"/> Air Rotary		
<input checked="" type="checkbox"/> OWWO <input type="checkbox"/> Expl <input type="checkbox"/> Wildcat <input type="checkbox"/> Cable		

Depth to Bottom of fresh water ~40 feet

Lowest usable water formation Dakota

Depth to Bottom of usable water ~600 feet

Surface pipe by Alternate: 1 2

Surface pipe: 2 1/4 in. hole

Conductor pipe if any required

Ground surface elevation

This Authorization Expires

Approved By

If OWWO: add well info as follows:

Operator Kansas Petro. Inc.

Well Name #1 Kuhn

Comp Date 12-7-75... Old Total Depth 3477

Projected Total Depth 3477 feet

Projected Formation at TD Arbuckle

Expected Producing Formations Lansing

I certify that we will comply with K.S.A. 55-101, et seq., plus eventually plugging hole to K.C.C. specifications.

Production string will be cemented immediately from below the usable water to the surface.

Date 7/24/85 Signature of Operator or Agent

LuAnne Corliss

Title as agent

RECEIVED


STATE CORPORATION COMMISSION

Must be filed with the K.C.C. five (5) days prior to commencing well
This card void if drilling not started within six (6) months of date received by K.C.C.

JUL 23 1985

CONSERVATION DIVISION
Wichita, Kansas

A Regular Section of Land
1 Mile = 5,280 Ft.

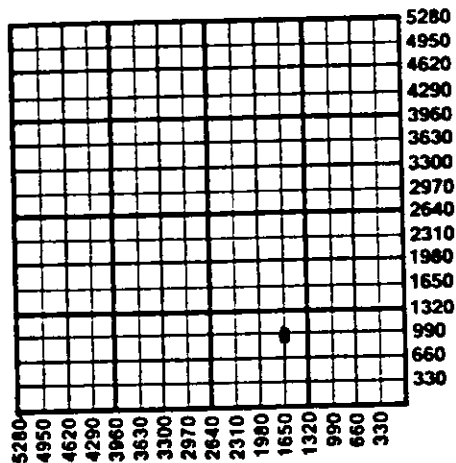

Important procedures to follow :

1. Notify District office before setting surface casing.
2. Set surface casing by circulating cement to the top.
3. File completion forms ACO-1 with K.C.C. within 90 days of well completion, following instructions on ACO-1, side 1, and including copies of wireline logs.
4. Notify District office 48 hours prior to old well workover or re-entry.
5. Prior to plugging, prepare a plugging plan, then obtain agreement from the appropriate district office for an approved plugging plan.
6. Submit plugging report (CP-4) to K.C.C. after plugging is completed.
7. Obtain an approved injection docket number before disposing of salt water.
8. Notify K.C.C. within 10 days when injection commences or terminates.
9. If an alternate 2 completion, cement in the production pipe from below any usable water to surface within 120 days of spud date.

State Corporation Commission of Kansas
Conservation Division
200 Colorado Derby Building
Wichita, Kansas 67202
(316) 263-3238