

CARD MUST BE TYPED

State of Kansas

CARD MUST BE SIGNED ✓

NOTICE OF INTENTION TO DRILL

(see rules on reverse side)

Starting Date May 3, 1988
month day year

API Number 15-051-24,553-0000

OPERATOR: License # 6246
Name Bennett & Schulte Oil Company
Address 112 W. 7th Box 329
City/State/Zip Russell, Kansas 67665
Contact Person Reginald Bennett Or Ralph Schulte
Phone (913)-483-2721SE. SE. SW. Sec. 3 Twp. 13 S. Rg. 16
330 Ft. from South Line of Section
2970 Ft. from East Line of Section

(Note: Locate well on Section Plat on reverse side)

CONTRACTOR: License # 8241
Name Emphasis Oil Operations
City/State Box 506 Russell, Kansas 67665Nearest lease or unit boundary line 330 feet
County EllisLease Name Froelich "E" Well # 5
Ground surface elevation 1975 Est. Gr. feet MSLWell Drilled For: Well Class: Type Equipment:
 Oil SWD Infield Mud Rotary
 Gas Inj Pool Ext. Air Rotary
 OWWO Expl Wildcat CableDomestic well within 330 feet: yes no
Municipal well within one mile: yes no
Surface pipe by Alternate: 2
Depth to bottom of fresh water 600
Depth to bottom of usable water 190
Surface pipe planned to be set 1125
Projected Total Depth 3500 feet
Formation Arbuckle

If OWWO: old well info as follows:

Operator
Well Name
Comp Date Old Total Depth

I certify that well will comply with K.S.A. 55-101, et seq., plus eventually plugging hole to KCC specifications.

cementing will be done immediately upon setting production casing
Date April 28, 1988 Signature of Operator or Agent Ralph L. Schulte Title Partner

For KCC Use:


Conductor Pipe Required feet; Minimum Surface Pipe Required 650 feet per Alt.
This Authorization Expires 10-29-88 EFFECTIVE 5-4-88 Approved By P.C.H. 4-29-88

Must be filed with the K.C.C. five (5) days prior to commencing well
This card void if drilling not started within six (6) months of date received by K.C.C.

Important procedures to follow:

1. Notify District office before setting surface casing.
2. Set surface casing by circulating cement to the top.
3. File completion forms ACO-1 with K.C.C. within 90 days of well completion, following instructions on ACO-1, side 1, and including copies of wireline logs.
4. Notify District office 48 hours prior to old well workover or re-entry.
5. Prior to filing Intent, prepare a proposed plugging plan in case well is D & A, then obtain approval of plan when calling district office prior to setting surface pipe.
6. Submit plugging report (CP-4) to K.C.C. after plugging is completed.
7. Obtain an approved injection docket number before disposing of salt water.
Notify K.C.C. within 10 days when injection commences or terminates.
8. If an alternate 2 completion, cement in the production pipe from bottom any usable water to surface within 120 days of spud date.

A Regular Section of Land
1 Mile = 5,280 Ft.

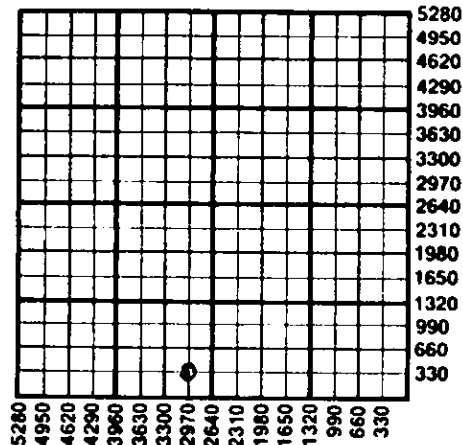

RECEIVED
STATE CORPORATION COMMISSION
APR 29 1969

CONSERVATION DIVISION
Wichita, Kansas

State Corporation Commission of Kansas
Conservation Division
200 Colorado Derby Building
Wichita, Kansas 67202
(316) 263-3238