

CARD MUST BE TYPED

State of Kansas

CARD MUST BE SIGNED

NOTICE OF INTENTION TO DRILL

(see rules on reverse side)

Starting Date 5 24 86
month day year

API Number 15- 051-24410-00-00

OPERATOR: License # 6246
Name Bennett & Schulte Oil Co.
Address P.O. Box 329
City/State/Zip Russell, Kansas 67665
Contact Person Ralph L. Schulte
Phone 913-483-2721NE SE SW Sec. 3 Twp. 13 S, Rg. 16 X East
990 Ft. from South Line of Section
2970 Ft. from East Line of Section

(Note: Locate well on Section Plat on reverse side)

CONTRACTOR: License # 8241
Name Emphasis Oil Operations
City/State P.O. Box 506, Russell, KS 67665Nearest lease or unit boundary line 330 feet
County Ellis
Lease Name Froelich B Well # 3Well Drilled For: Well Class: Type Equipment:
X Oil SWD X Infield X Mud Rotary
Gas Inj Pool Ext. Air Rotary
OWWO Expl Wildcat CableGround surface elevation 1995 feet MSL
Domestic well within 330 feet: yes X no
Municipal well within one mile: yes X no
Depth to bottom of fresh water 450
Depth to bottom of usable water 450-500
Surface pipe by Alternate: 1 XX 2 XX
Surface pipe planned to be set 1100
Conductor pipe required
Projected Total Depth 3500 feet
Formation Arbuckle

If OWWO: old well info as follows:

Operator
Well Name
Comp Date Old Total Depth

I certify that well will comply with K.S.A. 55-101, et seq., plus eventually plugging hole to KCC specifications.

Date 5-20-86 Signature of Operator or Agent *Diana C. E. Moore* Title as agent

For KCC Use:


Conductor Pipe Required feet; Minimum Surface Pipe Required 500 feet per All D 9This Authorization Expires 11-20-86 Approved By 5-20-86 *R*

Must be filed with the K.C.C. five (5) days prior to commencing well
This card void if drilling not started within six (6) months of date received by K.C.C.

Important procedures to follow:

1. Notify District office before setting surface casing.
2. Set surface casing by circulating cement to the top.
3. File completion forms ACO-1 with K.C.C. within 90 days of well completion, following instructions on ACO-1, side 1, and including copies of wireline logs.
4. Notify District office 48 hours prior to old well workover or re-entry.
5. Prior to filing Intent, prepare a proposed plugging plan in case well is D & A, then obtain approval of plan when calling district office prior to setting surface pipe.
6. Submit plugging report (CP-4) to K.C.C. after plugging is completed.
7. Obtain an approved injection docket number before disposing of salt water.
8. Notify K.C.C. within 10 days when injection commences or terminates.

**A Regular Section of Land
1 Mile = 5,280 Ft.**

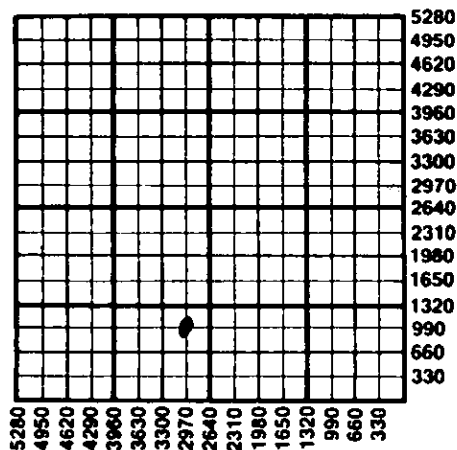

RECEIVED
STATE CORPORATION COMMISSION

9 If an alternate 2 completion, cement in the production pipe from below any usable water to surface within 120 days of spud date.

MAY 20 1986

CONSERVATION DIVISION
Wichita, Kansas

State Corporation Commission of Kansas
Conservation Division
200 Colorado Derby Building
Wichita, Kansas 67202
(316) 263-3238