

CARD MUST BE TYPED

State of Kansas

CARD MUST BE SIGNED ✓

NOTICE OF INTENTION TO DRILL

(see rules on reverse side)

Expected Spud Date. SEPT. 15 1987  
month day year

API Number 15- 135-23,160-00-00

OPERATOR: License # 03156  
Name ALLIGATOR-19 OIL CO.  
Address 215 E. 5th  
City/State/Zip HAYS, KANSAS 67601  
Contact Person RON NELSON  
Phone 913-628-3449

NE NW NW Sec. 21 Twp. 16 S, Rg. 22 East  
4950 West  
4290 Ft. from South Line of Section  
Ft. from East Line of Section

(Note: Locate well on Section Plat on reverse side)

CONTRACTOR: License # 5145  
Name DREILING OIL, INC.  
City/State VICTORIA, KANSAS

Nearest lease or unit boundary line 330 feet  
County NESS

Well Drilled For: Well Class: Type Equipment:  
 Oil  Storage  Infield  Mud Rotary  
 Gas  Inj  Pool Ext.  Air Rotary  
 OWWO  Expl  Wildcat  Cable

Lease Name B.YAN. "B" Well # 1  
Ground surface elevation N.A. feet MSL  
Domestic well within 330 feet:  yes  no  
Municipal well within one mile:  yes  no  
Depth to bottom of fresh water. 100' .....  
Depth to bottom of usable water 850' app. ....  
Surface pipe by Alternate: 1  2   
Surface pipe planned to be set 200' .....  
Conductor pipe required NONE  
Projected Total Depth 4400 feet  
Formation MISSISSIPPI

If OWWO: old well info as follows:

Operator .....  
Well Name .....  
Comp Date ..... Old Total Depth .....

I certify that well will comply with K.S.A. 55-101, et seq., plus eventually plugging hole to KCC specifications.

Date 8-26-87 Signature of Operator or Agent *Randy Dugan* Title PARTNER

For KCC Use:

Conductor Pipe Required ..... feet; Minimum Surface Pipe Required 200 feet per Alt. X 2


This Authorization Expires 2-26-88 Approved By *FA 8-26-87*

Must be filed with the K.C.C. five (5) days prior to commencing well  
This card void if drilling not started within six (6) months of date received by K.C.C.

Important procedures to follow:

1. Notify District office before setting surface casing.
2. Set surface casing by circulating cement to the top.
3. File completion forms ACO-1 with K.C.C. within 120 days of well spud date, following instructions on ACO-1, side 1, and including copies of wireline logs.
4. Notify District office 48 hours prior to old well workover or re-entry.
5. Prior to filing Intent, prepare a proposed plugging plan in case well is D & A, then obtain approval of plan when calling district office prior to setting surface pipe.
6. Submit plugging report (CP-4) to K.C.C. after plugging is completed.
7. Obtain an approved injection docket number before disposing of salt water.
8. Notify K.C.C. within 10 days when injection commences or terminates.
9. If an alternate 2 completion, cement in the production pipe from below any usable water to surface within 120 days of spud date.

A Regular Section of Land  
1 Mile = 5,280 Ft.

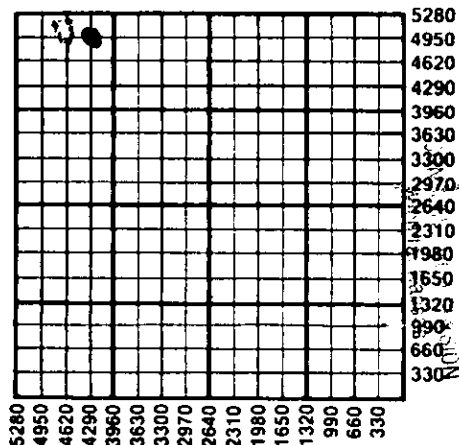

AUG 26 1987

STATE CORPORATION COMMISSION

08-26-1987

State Corporation Commission of Kansas  
Conservation Division  
200 Colorado Derby Building  
Wichita, Kansas 67202-1212  
(316) 263-3235