

CARD MUST BE TYPED

State of Kansas
NOTICE OF INTENTION TO DRILL
 (see rules on reverse side)

CARD MUST BE SIGNED

 Starting Date: AUGUST 5 1985
month day year

 API Number IS- 135-22,884-0000

 OPERATOR: License # 5430
 Name ENERGY THREE, INC.
 Address P.O. BOX 1505
 City/State/Zip GREAT BEND, KANSAS 67530
 Contact Person CHARLES DIXON
 Phone AC316-792-5968

 CENT. SE NE 29 Twp 18 S, Rge 24 East
(location) West

3300 Ft North from Southeast Corner of Section
660 Ft West from Southeast Corner of Section
 (Note: Locate well on Section Plat on reverse side)

 CONTRACTOR: License # 5836
 Name BIG THREE DRILLING, INC.
 City/State BOX 52, GORHAM, KS 67640

 Nearest lease or unit boundary line 660 feet.
 County NESS
 Lease Name STOECKLEIN Well # 1

 Well Drilled For: Well Class: Type Equipment:
 Oil Swd Infield Mud Rotary
 Gas Inj Pool Ext. Air Rotary
 OWWO Expl Wildcat Cable

 Domestic well within 330 feet: yes no
 Municipal well within one mile: yes no

If OWWO: old well info as follows:

 Operator
 Well Name
 Comp Date Old Total Depth
 Projected Total Depth 4450 feet
 Projected Formation at TD MISSISSIPPI
 Expected Producing Formations MISSISSIPPI

 Depth to Bottom of fresh water ~200 feet
 Lowest usable water formation DAKOTA
 Depth to Bottom of usable water 500 feet
 Surface pipe by Alternate: 1 2
 Surface pipe to be set 500 feet
 Conductor pipe if any required feet
 Ground surface elevation feet MSI.
 This Authorization Expires 1-25-86
 Approved By KCH 7-25-85

I certify that we will comply with K.S.A. 55-101, et seq., plus eventually plugging hole to K.C.C. specifications.

Date JULY 24, 1985Signature of Operator or Agent Charles Dixon


Title

EXECUTIVE VICE-PRESIDENT

Must be filed with the K.C.C. five (5) days prior to commencing well
This card void if drilling not started within six (6) months of date received by K.C.C.

Important procedures to follow :

A Regular Section of Land
1 Mile = 5,280 Ft.

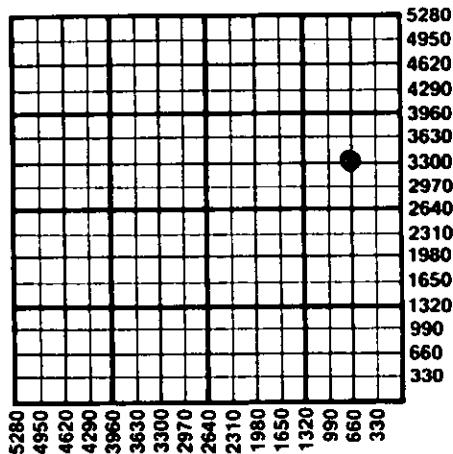

1. Notify District office before setting surface casing.
2. Set surface casing by circulating cement to the top.
3. File completion forms ACO-1 with K.C.C. within 90 days of well completion, following instructions on ACO-1, side 1, and including copies of wireline logs.
4. Notify District office 48 hours prior to old well workover or re-entry.
5. Prior to plugging, prepare a plugging plan, then obtain agreement from the appropriate district office for an approved plugging plan.
6. Submit plugging report (CP-4) to K.C.C. after plugging is completed.
7. Obtain an approved injection docket number before disposing of salt water.
8. Notify K.C.C. within 10 days when injection commences or terminates.
9. If an alternate 2 completion, cement in the production pipe from below any usable water to surface within 120 days of spud date.

JUL 25 1995

State Corporation Commission of Kansas
Conservation Division
200 Colorado Derby Building
Wichita, Kansas 67202
(316) 263-3238