

WELL PLUGGING RECORD

OR

FORMATION PLUGGING RECORD

Strike out upper line when reporting plugging off formations.

STATE OF KANSAS
STATE CORPORATION COMMISSION

Give All Information Completely
Make Required Affidavit
Mail or Deliver Report to:
Conservation Division
State Corporation Commission
800 Bittling Building
Wichita, Kansas

Ellis

County. Sec 9 Twp 11 Rge 18 (E) W (W)

Location as "NE¹/₄NW¹/₄SW¹/₄" or footage from lines NW/4 NW/4 NW/4

Lease Owner Phil-Han Oil Company Et al

Lease Name Johnson Well No. 1

Office Address 1407 Union Nat'l. Bk. Bldg. Wichita, Kansas

Character of Well (completed as Oil, Gas or Dry Hole) Dry

Date well completed April 10, 19 48

Application for plugging filed April 10 19 48

Application for plugging approved April 10 19 48


Plugging commenced April 10 19 48

Plugging completed April 10 19 48

Reason for abandonment of well or producing formation

If a producing well is abandoned, date of last production 19

Was permission obtained from the Conservation Division or its agents before plugging was commenced? yes

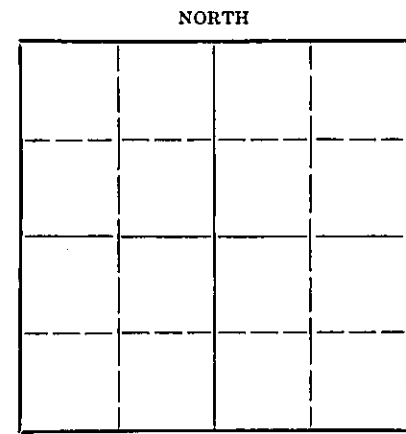

Locate well correctly on above Section Plat

Name of Conservation Agent who supervised plugging of this well M. A. Rives, Box #105, Hays, Kansas

Producing formation Depth to top Bottom Total Depth of Well 366 Feet

Show depth and thickness of all water, oil and gas formations.

OIL, GAS OR WATER RECORDS

CASING RECORD

Formation	Content	From	To	Size	Put In	Pulled Out
				8 5/8"	157'	None

Describe in detail the manner in which the well was plugged, indicating where the mud fluid was placed and the method or methods used in introducing it into the hold. If cement or other plugs were used, state the character of same and depth placed, from...feet to...feet for each plug set.

Set plug 200' filled with mud to 200' and cemented with 20 sacks cement, set Halliburton plug 25' below surface and cemented with 10 sacks cement.

4-17-48

APR 17 1948

(If additional description is necessary, use BACK of this sheet)

Correspondence regarding this well should be addressed to Earl F. Wakefield
Address 307 Union National Bank Building
Wichita, Kansas

STATE OF Kansas, COUNTY OF Sedgwick, ss.

Earl F. Wakefield (employee of owner) or (owner or operator) of the above-described well,

being first duly sworn on oath, says: That I have knowledge of the facts, statements, and matters herein contained and the log of the above-described well as filed and that the same are true and correct. So help me God.

(Signature) Earl F. Wakefield

(Address)

SUBSCRIBED AND SWORN to before me this 15th day of April, 1948

My commission expires 12-23-50

W. James Gaffney
Notary Public.

PLUGGING
FILE SEC 9 T 11 R 18
BOOK PAGE 21 LINE 33

LEASE: Johason #1
 OWNER: Phil-Han Oil Co. & et al
 CONTRACTOR: Earl F. Wakefield
 COMM: 3-24-48 COMP: 4-10-48

LOCATION: NW/4 NW/4 9-11-18
 COUNTY : Ellis County, Kansas
 CASING : 8 5/8 cemented @ 150

Gravel Clay	30	Chert & Shale	3562
Shale	75	Chert	3612
Shale Blue	163	Conglomerate	3617
Shale & Shells	390	Simpson Shale	3632
Sandy Shale	565	Simpson	3644
Sand & Iron	663	Arbuckle Lime	3662
Sand & Sandy Shale	1036	Total Depth	3662
Shale & Shells	1100		
Shale & Red Bed	1170		
Sand & Shale	1290		
Shale & Shells	1354		
Anhydrite	1393		
Shale & Shells	1451		
Shale & Red Bed	1590		
Shale & Shells	1721		
Shale & Salt	1830		
Lime & Shale	2067		
Broken Lime & Shale	2170		
Lime & Shale	2272		
Lime & Shale Breaks	2320		
Lime & Shale Streaks	2395		
Lime & Shale	2498		
Lime	2517		
Shale & Lime	2550		
Lime	2595		
Lime & Shale	2605		
Lime	2670		
Shale & Shells	2720		
Shale & Lime	2850		
Lime	2880		
Lime & Shale	2972		
Broken Lime & Shale	3030		
Lime	3042		
Lime & Shale	3100		
Lime	3270		
Shale	3275		
K.C. Lime	3303		
Lime	3376		
Cherty Lime	3400		
Lime	3477		
Lime Hard	3539		
Lime	3546		
Conglomerate	3552		

STATE OF KANSAS)
 COUNTY OF SEDGWICK) SS

I hereby certify that the above is a true and correct copy of
 the log of the Johason #1 well located in the NW/4 NW/4 9-11-18
 Ellis County, Kansas.

Subscribed and sworn to before me this 15th day of April 1948.

APR 17 1948

My Commission Expires: 12-23-50

PLUGGING

FILE SEC 9 T11 D184
 BOOK PAGE 71 LINE 33