


STATE OF KANSAS
STATE CORPORATION COMMISSION

WELL PLUGGING RECORD

Give All Information Completely
Make Required Affidavit
Mail or Deliver Report to:
Conservation Division
State Corporation Commission
800 Biting Building
Wichita, Kansas

Ellis County. Sec. 9 Twp. 11S Rge. 18 (E) W (W)
Location as "NE/CNW $\frac{1}{4}$ SW $\frac{1}{4}$ " or footage from lines SE SE SW
Lease Owner The Derby Oil Company
Lease Name Johnson "A" Well No. 1
Office Address P. O. Box 1030 Wichita, Kansas
Character of Well (completed as Oil, Gas or Dry Hole) Dry Hole
Date well completed Dec. 27 1950
Application for plugging filed Dec. 21 1950
Application for plugging approved Dec. 21 1950
Plugging commenced Dec. 21 1950
Plugging completed Dec. 27 1950
Reason for abandonment of well or producing formation Dry Hole

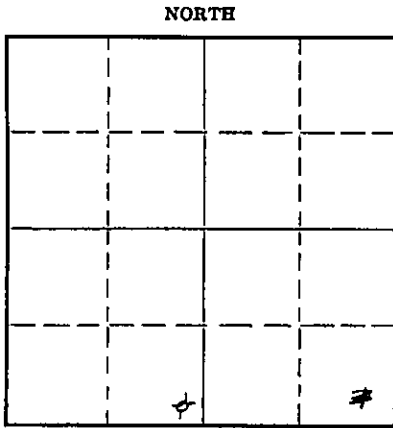

Locate well correctly on above
Section Plat

If a producing well is abandoned, date of last production 19...
Was permission obtained from the Conservation Division or its agents before plugging was com-
menced? Yes

Name of Conservation Agent who supervised plugging of this well E. R. Petty Hays, Kansas
Producing formation Depth to top Bottom Total Depth of Well 3550 Feet
Show depth and thickness of all water, oil and gas formations.

OIL, GAS OR WATER RECORDS

CASING RECORD

Formation	Content	From	To	Size	Put In	Pulled Out
		0	190	10 3/4"	190'	None

Describe in detail the manner in which the well was plugged, indicating where the mud fluid was placed and the method or methods used in introducing it into the hole. If cement or other plugs were used, state the character of same and depth placed, from...feet to...feet for each plug set.

3550' - 181 $\frac{1}{2}$ ' - Heavy Rotary Mud
181 $\frac{1}{2}$ ' - 180' - Wooden Plug
180' - 6' - 90 sacks cement
6' - Surface - Cellar

(If additional description is necessary, use BACK of this sheet)


Correspondence regarding this well should be addressed to The Derby Oil Company
Address P. O. Box 1030 Wichita, Kansas

STATE OF 1 Kansas, COUNTY OF Barton, ss.
Glenn Peel Drilling Company, Inc. (employee of owner) or (owner or operator) of the above-described well,
being first duly sworn on oath, says: That I have knowledge of the facts, statements, and matters herein contained and the log of the above-
described well as filed and that the same are true and correct. So help me God. GLENN PEEL DRILLING COMPANY, INC.

BY: *Glenn Peel*
(Signature) P. O. BOX 359 HOISINGTON, KANSAS
(Address)

SUBSCRIBED AND SWORN to before me this 27th day of December, 1950

My commission expires June 4, 1951
Marion M. Harter
Notary Public.

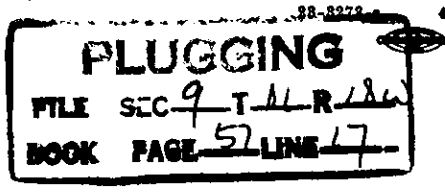

DRILLER'S LOG

Company: The Derby Oil Co.

SE SE SW
Sec. 9 Twp. 11S Rge. 18W

Farm: Johnson "A" Well No. 1

Comm: 12-9-50 Comp: 12-27-50

County: Ellis,
Kansas

Contractor: Glenn Peel Drilling Co., Inc.

Total Depth: 3550'

Elevation:

Casing: 10 3/4 " 190' cem.

Production: Dry

Figures below indicate bottom of formations

Sand & Gravel	0 -	15
Shale & Shells		190
Shale		360
Sand		372
Shale		400
Shale & Shells		760
Sand		880
Shale & Shells		1215
Anhydrite		1247
Red Bed & Shale		1440
Shale & Shells		1595
Shale & Salt		1670
Shale & Shells		1790
Shale, Shells & Lime		1940
Shale		2030
Lime		2055
Shale & Lime		2175
Lime		2345
Broken Lime & Shale		2410
Lime & Shale		2950
Lime		2990
Shale & Lime		3000
Lime		3370
Cherty Lime		3445
Lime		3550
Total Depth		3550

This is to certify that the above information is, to the best of our knowledge true and correct.

GLENN PEEL DRILLING COMPANY, INC.

BY: [Signature]

SUBSCRIBED AND SWORN to before me this 27th day of December, 1950.

My commission expires June 4, 1951 [Signature]
Notary Public

PLUGGING
FILE SEC-9-T-11-R-18-W
BOOK PAGE 51 LINE 17