


STATE OF KANSAS  
STATE CORPORATION COMMISSION

WELL PLUGGING RECORD

Give All Information Completely  
Make Required Affidavit  
Mail or Deliver Report to:  
Conservation Division  
State Corporation Commission  
211 No. Broadway  
Wichita, Kansas

Ellis County. Sec. 9 Twp. 11 Rge. 18 (E) W (W)  
Location as "NE/CNW/SW" or footage from lines 2650/S; 330'/E  
Lease Owner Shade & Barry  
Lease Name Meistrall - Unit Well No. 1  
Office Address 401 Ritz Building, Tulsa, Oklahoma  
Character of Well (completed as Oil, Gas or Dry Hole) Dry Hole  
Date well completed July 11th 1956  
Application for plugging filed 7-11 1956  
Application for plugging approved 7-11 1956  
Plugging commenced 7-11 1956  
Plugging completed 7-11 1956  
Reason for abandonment of well or producing formation \_\_\_\_\_

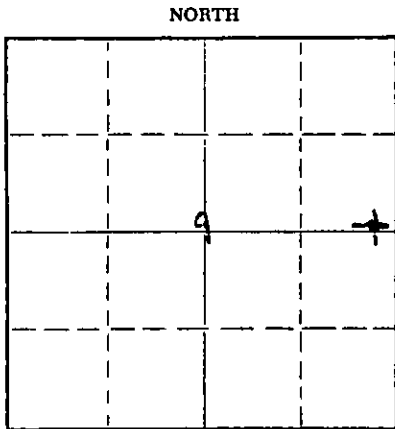

Locate well correctly on above  
Section Plot

If a producing well is abandoned, date of last production \_\_\_\_\_ 19\_\_\_\_  
Was permission obtained from the Conservation Division or its agents before plugging was com-  
menced? Yes

Name of Conservation Agent who supervised plugging of this well ~~Edmond~~ Milton Galyardt, Box 145, Russell  
Producing formation \_\_\_\_\_ Depth to top \_\_\_\_\_ Bottom \_\_\_\_\_ Total Depth of Well \_\_\_\_\_ Feet  
Show depth and thickness of all water, oil and gas formations.

OIL, GAS OR WATER RECORDS

CASING RECORD

FORMATION	CONTENT	FROM	TO	SIZE	PUT IN	PULLED OUT
				8-5/8	1196'	none

Describe in detail the manner in which the well was plugged, indicating where the mud fluid was placed and the method or methods used in introducing it into the hole. If cement or other plugs were used, state the character of same and depth placed, from \_\_\_\_\_ feet to \_\_\_\_\_ feet for each plug set.

Filled hole to 275' with heavy drilling mud, set plug and cemented with 15 sacks cement. Filled hole to 40 feet with heavy drilling mud, set plug and cemented to bottom of cellar with 10 sacks of cement.

RECEIVED  
STATE CORPORATION COMMISSION

7-25-56 JUL 25 1956

CONSERVATION DIVISION  
Wichita, Kansas

(If additional description is necessary, use BACK of this sheet)

Name of Plugging Contractor Transit Corporation  
Address 1516 Liberty Bank Bldg., Oklahoma City, Oklahoma

STATE OF OKLAHOMA, COUNTY OF TULSA, ss.  
R. G. Barry (owner or operator) of the above-described well, being first duly sworn on oath, says: That I have knowledge of the facts, statements, and matters herein contained and the log of the above-described well as filed and that the same are true and correct. So help me God.

By: R. G. Barry  
Shade & Barry  
401 Ritz Building, Tulsa, Oklahoma  
(Address)

SUBSCRIBED AND SWORN TO before me this 24th day of July, 1956

My commission expires May 4, 1958  
Maxine England Notary Public.

PLUGGING  
FILE SEC 9 T. 11 R. 18W  
BOOK PAGE 80 LINE 1

